

HARRISON
C 106
8-23-74

MISSISSIPPI
 BOARD OF WATER COMMISSIONERS
 416 North State Street
 Jackson, Mississippi 39201 **CODED**

WATER WELL DRILLERS LOG

8-23 1974 Panellanderson Harrison
 date well completed firm name county well located

LANDOWNER:

Alvon Vogle
Rt 1 Saucier
 (mailing address)

description of formations encountered

	from	to
<u>Top Soil</u>	<u>0</u>	<u>4</u>
<u>white clay</u>	<u>4</u>	<u>24</u>
<u>Blue clay</u>	<u>24</u>	<u>28</u>
<u>Fine Sand</u>	<u>28</u>	<u>74</u>
<u>Coarse Sand</u>	<u>74</u>	<u>104</u>

WELL LOCATION:

sec. 33 T. 4 S. R. 11
8 miles E of Saucier
 (distance) (direction) (nearest town)

WELL PURPOSE: HOME
 (home, irrigation, municipal, industrial)

CODED

WELL COMPLETION DATA:

- (1) diameter (inches) 2"
- (2) total depth (feet) 104'
- (3) static water level (feet) 62' ^{below} ~~above~~ top of ground.
- (4) casing Plastic 99'
 (material) (depth)
- (size) If telescope see back.
- (5) screen 5' 99'
 (length) (depth to top)
- 2" Plastic
 (size) (material)
- (6) pump 1 9
 (HP) (yield gpm)
- Elect
 (type power)
- (7) electric log no
 (yes or no)

(organization running log)

(8) how well bottom plugged? Plugged


DRILLERS REMARKS:

REGISTERED

SEP - 5 1974

If well telescopes please sketch and show depths.

GROUND LEVEL

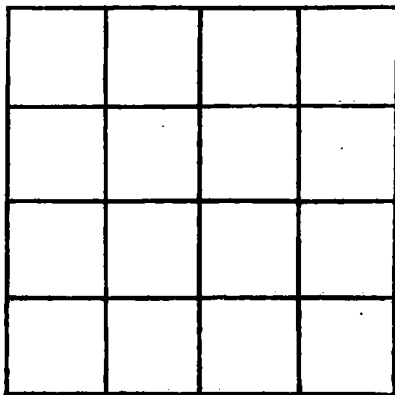

SECTION _____

Please indicate well location X.

ADDITIONAL INFORMATION

If more than one screen,
show locations of each on sketch.