

HARRISON
C107
8-21-74

MISSISSIPPI
 BOARD OF WATER COMMISSIONERS
 416 North State Street
 Jackson, Mississippi 39201

CODED

WATER WELL DRILLERS LOG

8-21 1974
 date well completed

Parnell Anderson
 firm name

Harrison
 county well located

LANDOWNER:

Larry Shoemaker

(mailing address)

WELL LOCATION:

sec. 13 T. 5 S. R. 11 E.
 20 miles N of Gulfport
 (distance) (direction) (nearest town)

WELL PURPOSE:

HOME
 (home, irrigation, municipal, industrial)

WELL COMPLETION DATA:

- (1) diameter (inches) 2"
- (2) total depth (feet) 95'
- (3) static water level (feet) 37' below top of ground
- (4) casing Plastic 90' (material) (depth)
- (size) If telescope see back.
- (5) screen 5' 90' (length) (depth to top)
- 2" Plastic (size) (material)
- (6) pump 1 (HP) 10 (yield gpm)
- Elect (type power)
- (7) electric log no (yes or no)

(organization running log)

(8) has well bottom plugged Back wash valve

description of formations encountered

from to

Top soil	0	4
Red Clay	4	25
Thin sand	26	48
Pink clay	48	52
Coarse sand	52	95

CODED


DRILLERS REMARKS:

DECLARED
 ALL
 SEP 5 1974

MISS. BD. OF WATER COMMISSIONERS

If well telescopes please sketch and show depths.

GROUND LEVEL

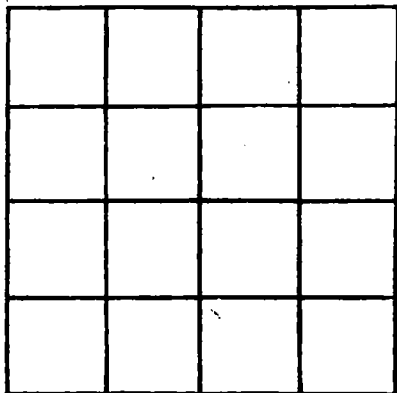

SECTION _____

Please indicate well location X.

ADDITIONAL INFORMATION

If more than one screen, show locations of each on sketch.