

**HARRISON**  
**C 108**  
**8-19-74**

MISSISSIPPI  
 BOARD OF WATER COMMISSIONERS **CODED**  
 416 North State Street  
 Jackson, Mississippi 39201

**WATER WELL DRILLERS LOG**

8-19 1974 Parrell Anderson Harrison  
 date well completed firm name county well located

**LANDOWNER:**  
B. Evelyn Yates  
Rt 1 Dandies  
 (mailing address)

**WELL LOCATION:**  
 sec 27 T 5 S R 11 W  
13 miles E of Dandies  
 (distance) (direction) (nearest town)

**WELL PURPOSE:** HOME  
 (home, irrigation, municipal, industrial)

**WELL COMPLETION DATA:**

(1) diameter (inches) 2"

(2) total depth (feet) 380'

(3) static water level (feet) 45' below top of ground

(4) casing Plastic, 375'  
 (material) (depth)

(size) If telescope see back.

(5) screen 5', 375'  
 (length) (depth to top)

2", Plastic  
 (size) (material)

(6) pump 1 (HP) 10 (yield gpm)

Elect  
 (type power)

(7) electric log no  
 (yes or no)

(organization running log)

description of formations encountered	from	to
<u>Top Soil</u>	<u>0</u>	<u>4</u>
<u>White Clay</u>	<u>4</u>	<u>48</u>
<u>Blue Clay</u>	<u>48</u>	<u>70</u>
<u>Fine Sand</u>	<u>78</u>	<u>84</u>
<u>Blue Clay</u>	<u>84</u>	<u>190</u>
<u>Fine Sand</u>	<u>190</u>	<u>210</u>
<u>Blue Clay</u>	<u>210</u>	<u>350</u>
<u>Coarse Sand</u>	<u>350</u>	<u>380</u>

**CODED**

**RECORDED**


SEP - 5 1974

**DRILLERS REMARKS:**

(8) how well bottom plugged  
Back wash valve

If well telescopes please sketch and show depths.

GROUND LEVEL

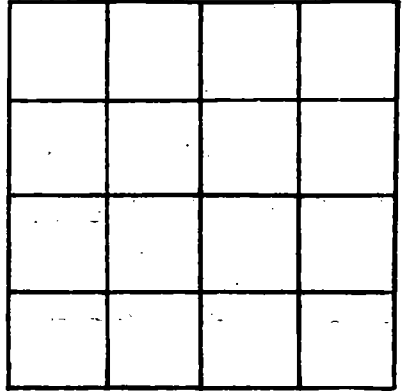

SECTION \_\_\_\_\_

Please indicate well location X.

ADDITIONAL INFORMATION

A series of horizontal lines providing space for additional information.

If more than one screen, show locations of each on sketch.