

**HARRISON**  
**C 109**  
**4-15-74**

MISSISSIPPI  
 BOARD OF WATER COMMISSIONERS  
 416 North State Street  
 Jackson, Mississippi 39201  
**WATER WELL DRILLERS LOG**

**CODED**

8-15  
 date well completed

1974 Darsell Anderson  
 firm name

Harrison  
 county well located

**LANDOWNER:**

Jerry Bellew

(mailing address)

**WELL LOCATION:**

sec. 26 T. 5 S. R. 11 E.  
22 miles N of Dallport  
 (distance) (direction) (nearest town)

**WELL PURPOSE:** HOME  
 (home, irrigation, municipal, industrial)

**WELL COMPLETION DATA:**

- (1) diameter (inches) 2"
  - (2) total depth (feet) 75'
  - (3) static water level (feet) 37' below ~~above~~ top of ground.
  - (4) casing Plastic, 90'  
 (material) (depth)  
 (size) if telescope see back.
  - (5) screen 3', 90'  
 (length) (depth to top)  
2", Plastic  
 (size) (material)
  - (6) pump 1, 10  
 (HP) (yield gpm)  
Elect  
 (type power)
  - (7) electric log no  
 (yes or no)
- (organization running log)

**description of formations encountered**

from to

<u>Top Soil</u>	<u>0</u>	<u>5'</u>
<u>Red Clay</u>	<u>5'</u>	<u>28'</u>
<u>Fine Sand</u>	<u>28'</u>	<u>78'</u>
<u>Coarse Sand</u>	<u>78'</u>	<u>95'</u>

**CODED**

(8) how well bottom plugged  
Back wash valve


**DRILLERS REMARKS:**

**REC-111**  
**SEP - 5 1974**

**MISS. BD. OF WATER COMM.**

If well telescopes please sketch and show depths.

GROUND LEVEL

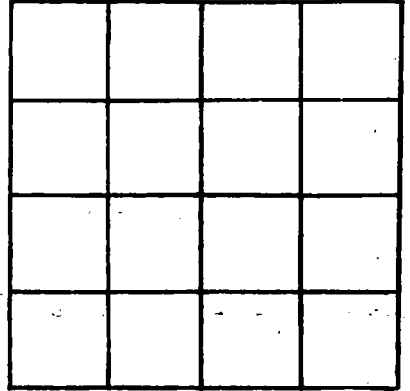

SECTION \_\_\_\_\_

Please indicate well location X.

ADDITIONAL INFORMATION

If more than one screen, show locations of each on sketch.