

Harrison
 CII
 10/2/74

MISSISSIPPI
 BOARD OF WATER COMMISSIONERS
 416 North State Street
 Jackson, Mississippi 39201

CODED

WATER WELL DRILLERS LOG

Oct. 2 1974 McGill Well Works Harrison
 date well completed firm name county well located

LANDOWNER: Mrs. Mitchell

description of formations encountered

from to

R-2 Box 3

Sauvier, Miss. 39579
 (mailing address)

Sand	0	10
Clay	10	63
Blue clay	63	210
Mud	210	247
fine sand	247	252
mud	252	278
fine sand	278	294
water sand	294	346

WELL LOCATION:


sec. 17 T. 5 N R. 11 E
5 miles SE of Sauvier
 (distance) (direction) (nearest town)

WELL PURPOSE:

home irrigation, municipal, industrial

WELL COMPLETION DATA:

- (1) diameter (inches) 2"
- (2) total depth (feet) 346'
- (3) static water level (feet) 62' below top of ground
- (4) casing 55.336' 2"
 (material) (depth)
- if telescope see back.
 (size)
- (5) screen 10' 10'
 (length) (depth to top)
2" 5.5.
 (size) (material)
- (6) pump 1 8
 (HP) (yield gpm)
Electric
 (type power)
- (7) electric log no.
 (yes or no)
no.
 (organization running log)
- (8) how well bottom plugged sand
Shank - wash - wash valve

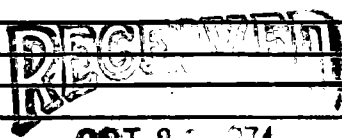

OCT 2 1974

DRILLERS REMARKS:

If well telescopes please sketch and show depths.

GROUND LEVEL

			X

SECTION 17

Please indicate well location X.

ADDITIONAL INFORMATION

If more than one screen, show locations of each on sketch.