

HARRISON

CI12

1-15-75

Elect # 112

1-15-75

date well completed

MISSISSIPPI BOARD OF WATER COMMISSIONERS
416 North State Street
Jackson, Mississippi 39201

WATER WELL DRILLERS LOG

M+B Drilling Co

firm name

Harrison

county well located

LANDOWNER:

Nolan Adams

Rt-1 Sauer, Miss

(mailing address)

WELL LOCATION:

sec. 20 T 5 N R 11 E S W

2 miles S of Sauer (distance) (direction) (nearest town)

WELL PURPOSE:

Home (home, irrigation, municipal, industrial)

WELL COMPLETION DATA:

- (1) diameter (inches) 2
- (2) total depth (feet) 1190
- (3) static water level (feet) 45 below top of ground
- (4) casing (material) PRC (depth) Total 2" If telescope see back. (size)
- (5) screen 20 (length) 10 (depth to top) 2" PRC (size) (material)
- (6) pump 1 (HP) 10 (yield gpm) 2.5 10 (type power)
- (7) electric log YES (yes or no) MSGS (organization running log)
- (8) how well bottom plugged 2" BW valve

description of formations encountered

from to

Clay	0	10
Sand	10	80
White Clay	80	135
Sand	135	142
Blue Clay	142	150
sand & clay breaks	150	165
Sand	165	175
Sand & Clay Breaks	175	210
Sand	210	225
Blue Clay	225	260
Coarse Sand - Fine	260	300
Coarse Sand	300	325
Clay	325	330
Coarse Sand	330	400
Blue Clay	400	600
Fine Sand	600	612
Blue Clay	612	1085
Sand	1085	1100
Blue Clay	1100	1130
Sand	1130	1140
Blue Clay	1140	1190
Sand		
Blue clay		
Screen top 1090-1100		
		1130-1140

RECEIVED


JUL 19 1976

DRILLERS REMARKS:

MISS. BD. OF WATER COM

If well telescopes please sketch and show depths.

GROUND LEVEL

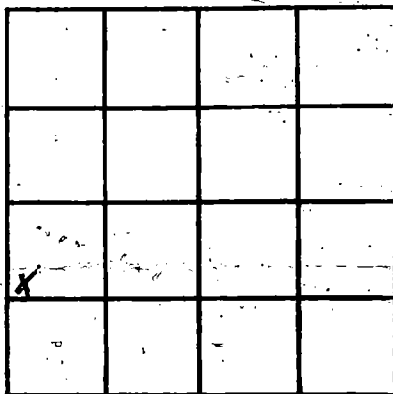

SECTION 20

Please indicate well location X.

ADDITIONAL INFORMATION

Lined area for additional information.

If more than one screen, show locations of each on sketch.