


Harrison
C113
12-16-74

MISSISSIPPI
BOARD OF WATER COMMISSIONERS
416 North State Street
Jackson, Mississippi 39201
CODED
WATER WELL DRILLERS LOG

12/16 date well completed 1974 Parnell Anderson Harrison firm name Harrison county well located


LANDOWNER:	description of formations encountered	from	to
Ronald Swargo	Top soil	0	4'
(mailing address)	red clay	4'	28'
WELL LOCATION:	sandy clay	28'	35'
sec. 13 T 5 S R 11 W	fine CODED sand	35'	50'
1/2 miles E of SUCCESS (distance) (direction) (nearest town)	white clay	50'	60'
WELL PURPOSE: <u>Lane</u> (home, irrigation, municipal, industrial)	coarse sand	60'	80'
WELL COMPLETION DATA:			
(1) diameter (inches) <u>2"</u>			
(2) total depth (feet) <u>80'</u>			
(3) static water level (feet) <u>60'</u> below above top of ground.			
(4) casing <u>plastic</u> (material) <u>75'</u> (depth)			
(size) if telescope see back.			
(5) screen <u>5'</u> (length) <u>75'</u> (depth to top)			
<u>2"</u> (size) <u>plastic</u> (material)			
(6) pump <u>1</u> (HP) <u>79 gpm</u> (yield gpm)			
<u>electric</u> (type power)			
(7) electric log <u>no</u> (yes or no)			
(organization running log)			
(8) how well bottom plugged <u>back wash valve</u>			
DRILLERS REMARKS:			

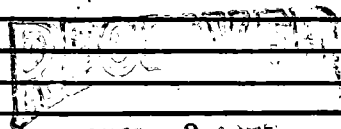

JAN 8 1975

If well telescopes please sketch and show depths.

GROUND LEVEL

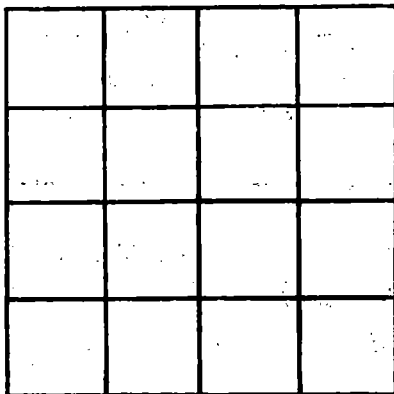

SECTION _____

Please indicate well location X.

ADDITIONAL INFORMATION

If more than one screen, show locations of each on sketch.