

HARRISON
C115
2-6-75

MISSISSIPPI
BOARD OF WATER COMMISSIONERS
416 North State Street
Jackson, Mississippi 39201

WATER WELL DRILLERS LOG

2-6 1975 Phennell Anderson Harrison
date well completed firm name county well located


LANDOWNER:	description of formations encountered	from	to
<u>Jack Herwin</u>	<u>Top Soil</u>	<u>0</u>	<u>5</u>
(mailing address)	<u>Red Sand</u>	<u>5</u>	<u>28</u>
WELL LOCATION:	<u>Blue Clay</u>	<u>28</u>	<u>88</u>
sec. <u>17</u> T. <u>5</u> R. <u>11</u>	<u>Thin Sand</u>	<u>88</u>	<u>100</u>
<u>1 1/2</u> miles <u>S</u> of <u>Anders</u>	<u>Coarse Sand</u>	<u>100</u>	<u>105</u>
(distance) (direction) (nearest town)			
WELL PURPOSE: <u>HOME</u>			
(home, irrigation, municipal, industrial)			
WELL COMPLETION DATA:			
(1) diameter (inches) <u>2"</u>			
(2) total depth (feet) <u>105'</u>			
(3) static water level (feet) <u>15'</u> below top of ground.			
(4) casing <u>Plastic</u> , <u>100'</u>			
(material) (depth)			
(size) If telescope see back.			
(5) screen <u>5'</u> , <u>100'</u>			
(length) (depth to top)			
<u>2"</u> , <u>Plastic</u>			
(size) (material)			
(6) pump <u>1</u> , <u>12</u>			
(HP) (yield gpm)			
<u>Elect</u>			
(type power)			
(7) electric log <u>no</u>			
(yes or no)			
(organization running log)			
(8) how well bottom plugged <u>Back with valve</u>			
DRILLERS REMARKS:			

DRILLERS
REMARKS
MAR 13 1975

MISS. BD. OF WATER COMM.

If well telescopes please sketch and show depths.

GROUND LEVEL

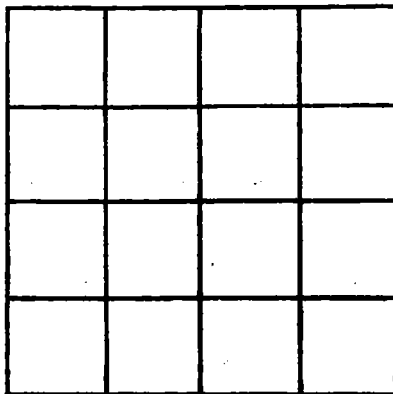

SECTION _____

Please indicate well location X.

ADDITIONAL INFORMATION

If more than one screen, show locations of each on sketch.