

HARRISON
C116
3-21-75

MISSISSIPPI
BOARD OF WATER COMMISSIONERS
416 North State Street
Jackson, Mississippi 39201

CODED

WATER WELL DRILLERS LOG

3-21 1975 Darnell Anderson, Harrison
date well completed firm name county well located

LANDOWNER:	description of formations encountered	from	to
J. B. Jones	Top Soil	0	4
(mailing address)	Red Clay	4	22
WELL LOCATION:	White Clay	22	45
sec. <u>26</u> T. <u>5</u> N. R. <u>11</u> E	Coarse Sand	45	81
<u>8</u> miles <u>S E</u> of <u>Jackson</u>			
(distance) (direction) (nearest town)			
WELL PURPOSE: <u>HOME</u>			
(home, irrigation, municipal, industrial)			
WELL COMPLETION DATA:			
(1) diameter (inches) <u>2"</u>			
(2) total depth (feet) <u>81'</u>			
(3) static water level (feet) <u>23'</u> below top of ground			
(4) casing <u>Plastic, 76'</u>			
(material) (depth)			
(size) if telescope see back.			
(5) screen <u>5' 76'</u>			
(length) (depth to top)			
<u>2" Plastic</u>			
(size) (material)			
(6) pump <u>1</u> <u>5</u>			
(HP) (yield gpm)			
<u>Elect</u>			
(type power)			
(7) electric log <u>no</u>			
(yes or no)			
(organization running log)			
(8) has well bottom plugged <u>Backwash valve</u>			
DRILLERS REMARKS:			


CODED

RECEIVED
MAR 31 1975

MISS. BD. OF WATER COMM

If well telescopes please sketch and show depths.

GROUND LEVEL

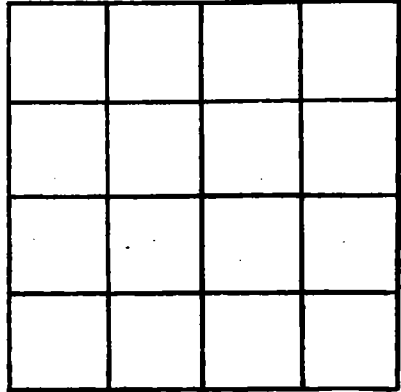

SECTION _____

Please indicate well location X.

ADDITIONAL INFORMATION

If more than one screen, show locations of each on sketch.