

HARRISON
C 117
3-25-75

MISSISSIPPI
BOARD OF WATER COMMISSIONERS
416 North State Street
Jackson, Mississippi 39201

CODED

WATER WELL DRILLERS LOG

3-25
date well completed

1975 Bernell Anderson
firm name

Harrison
county well located

LANDOWNER:
Charles Jones
(mailing address)

WELL LOCATION:
sec. 2 T. 6 R. 11
S. S. S. S.
5 miles E of Jackson
(distance) (direction) (nearest town)

WELL PURPOSE: HOME
(home, irrigation, municipal, industrial)

WELL COMPLETION DATA:

(1) diameter (inches) 2"

(2) total depth (feet) 92'

(3) static water level (feet) 5.8' below top of ground.

(4) casing Plastic 87'
(material) (depth)

(size) If telescope see back.

(5) screen 5' 87'
(length) (depth to top)

2 Plastic
(size) (material)

(6) pump 1 9
(HP) (yield gpm)

Elect
(type power)

(7) electric log no
(yes or no)

(organization running log)

(8) how well bottom plugged
Plugged

description of formations encountered	from	to
<u>Top Soil</u>	<u>0</u>	<u>3</u>
<u>Sandy Clay</u>	<u>3</u>	<u>65</u>
<u>Coarse Sand</u>	<u>65</u>	<u>75</u>
<u>Red Clay</u>	<u>75</u>	<u>80</u>
<u>Coarse Sand</u>	<u>80</u>	<u>92'</u>


RECEIVED
MAR 31 1975

MISS. BD. OF WATER COMM.

DRILLERS REMARKS:

If well telescopes please sketch and show depths.

GROUND LEVEL

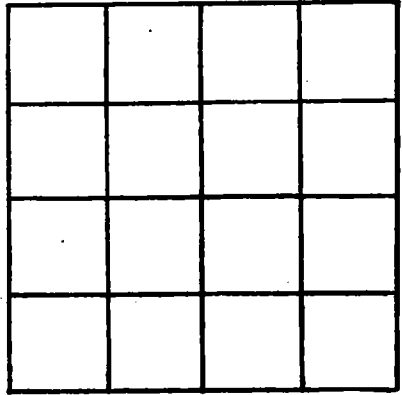

SECTION _____

Please indicate well location X.

ADDITIONAL INFORMATION

If more than one screen, show locations of each on sketch.