

HARRISON

C 118

8-17-79

MISSISSIPPI BOARD OF WATER COMMISSIONERS
416 North State Street
Jackson, Mississippi 39201

CODED

WATER WELL DRILLERS LOG

8-17-1979 Braden Pump and Harrison
date well completed firm name county well located
Wood Sel. Inc.

LANDOWNER Charles Apple

description of formations encountered

from to

~~Box 131F~~ Box 131F

Saucier, Miss.
(mailing address)

WELL LOCATION:

sec 24 T 5 S R 11 W
5 miles NE of Lyman
(distance) (direction) (nearest town)

WELL PURPOSE:

(home, irrigation, municipal, industrial) Home

WELL COMPLETION DATA:

- (1) diameter (inches) 2"
- (2) total depth (feet) 600
- (3) static water level (feet) 135 below top of ground.

(4) casing PVC total (material) (depth)

2" (size) If telescope see back.

(5) screen 10' 585' (length) (depth to top)

2" 100% PVC underbar (size) (material)

(6) pump 1 1/2 6 (HP) (yield gpm)

220V 1Ø (type power)

(7) electric log NO (yes or no)

(organization running log)

(8) how well bottom plugged 2" seal head

Clay	0	60
sand CODED	60	120
sand + gravel	120	140
Clay	140	160
sand	160	200
yellow clay	200	220
blue clay	220	240
sand	240	260
blue clay	260	310
clay + sand	310	320
blue clay	320	340
clay + sand	340	360
clay	360	425
sand	425	436
Clay	436	530
sand	530	600

DEPT. OF NATURAL RESOURCES
BUREAU OF LAND & WATER REVENUE

OCT 16 1979


RECEIVED

DRILLERS REMARKS:

5ft tail pipe
below screen

If well telescopes please sketch and show depths.

GROUND LEVEL

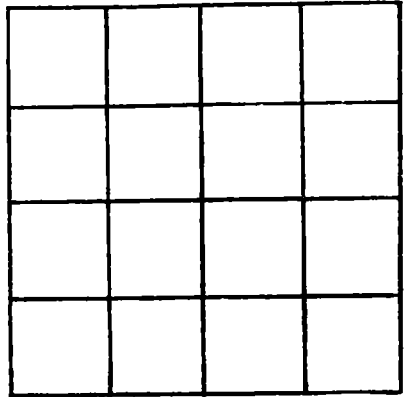

SECTION _____

Please indicate well location X.

ADDITIONAL INFORMATION

If more than one screen, show locations of each on sketch.