


HARRISON
C-128
10-4-80

MISSISSIPPI
BOARD OF WATER COMMISSIONERS
416 North State Street
Jackson, Mississippi 39201
WATER WELL DRILLERS LOG

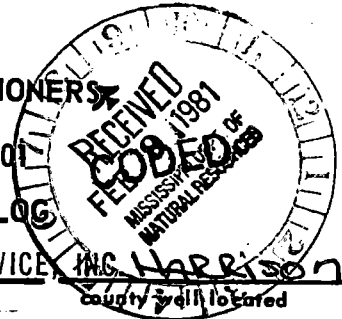

10-4-80 date well completed
BRADEN PUMP AND WELL SERVICE, INC. firm name
HARRISON county well located

LANDOWNER:	description of formations encountered	from	to
Dennis HARMER Rt 2, Box 148	Clay	0	20
Saucier, MS (mailing address)	Sand	20	60
WELL LOCATION:	Sand + gravel	60	80
sec 24 T 5 N R 11 E	Clay	80	110
5 miles SE of SAUCIER	Gravel	110	125
(distance) (direction) (nearest town)	Clay	125	260
WELL PURPOSE: home	Sand	260	265
(home, irrigation, municipal, industrial)	Clay	265	300
WELL COMPLETION DATA:	Sand	300	360
(1) diameter (inches) 4"			
(2) total depth (feet) 360			
(3) static water level (feet) 130 below top of ground			
(4) casing PVC, total 4" (size) If telescope see back.			
(5) screen 10' (length), 340' (depth to top)			
4" (size), PVC underbar (material)			
(6) pump 1 1/2 (HP), 25 (yield gpm)			
230 (type power)			
(7) electric log no (yes or no)			
(organization running log)			
(8) how well bottom plugged 4" BW valve			
DRILLERS REMARKS:			
10' tail pipe			

If well telescopes please sketch and show depths.

41000

GROUND LEVEL

X			

SECTION 24

Please indicate well location X.

ADDITIONAL INFORMATION

If more than one screen,
show locations of each on sketch.