

HARRISON
 C. 130
 9.19.75

MISSISSIPPI
 BOARD OF WATER COMMISSIONERS
 416 North State Street
 Jackson, Mississippi 39201

CODED
 CODED

WATER WELL DRILLERS LOG

9/19 1975 COASTAL DRILLING & SERVICE CO. Harrison
 date well completed ROUTE 1 BOX 618 county well located

LANDOWNERS: Stratton, H. & H. JR.
 pt 2
 Sauer, Miss
 (milling address)

SS	39532	description of formations encountered	from	to
		Top Soil	1	3
		Red Clay Sand	3	40
		clay	40	63
		Soft Blue Clay	63	110
		hard Blue Clay	110	210
		fine water Sand	210	230
		very hard Blue Clay	230	290
		fine water Sand	290	300
		Coarse water Sand	300	343

WELL LOCATION:
 sec. 35 T. 4 N. R. 11 E.
 2 1/2 miles NE of Fort, Miss.
 (distance) (direction) (nearest town)

WELL PURPOSE: private home
 (home, irrigation, municipal, industrial)

WELL COMPLETION DATA:

(1) diameter (inches) 4"

(2) total depth (feet) 343'

(3) static water level (feet) 100 below top of ground.

(4) casing PVC, 323'
 (material) (depth)
 (size) If telescope see back.

(5) screen 20', 323'
 (length) (depth to top)
4", PVC
 (size) (material)

(6) pump 2HP, 30
 (HP) (yield gpm)
Ele
 (type power)

(7) electric log no
 (yes or no)

(organization running log)

CODED
 CODED


(8) how well bottom plugged
2" ball wash valve

DRILLERS REMARKS:
None

MAR 17 1976

If well telescopes please sketch and show depths.

GROUND LEVEL

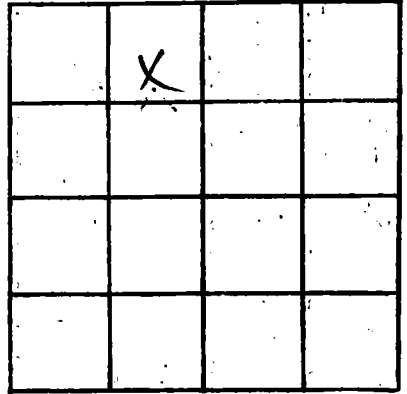

SECTION _____

Please indicate well location X.

ADDITIONAL INFORMATION

If more than one screen, show locations of each on sketch.