

HARRISON
C 131
10-3-75

MISSISSIPPI
BOARD OF WATER COMMISSIONERS
416 North State Street
Jackson, Mississippi 39201

CODED

WATER WELL DRILLERS LOG
COASTAL DRILLING & SERVICE CO.

10/3 19 25 date well completed
ROUTE # BOX 618 county well located Harrison

LANDOWNER W.W. Johnson
RT 3 Box 604
Hpt. Min
(mailing address)

description of formations encountered	from	to
top soil	1	3
Red Clay	3	15
glauca	15	20
white sand	20	45
Soft blue clay	45	105
white sand	105	125
hard blue clay	125	250
fine white sand	250	265
course white sand	265	300

WELL LOCATION:
sec. 36 T 5 N R 11 E

_____ miles _____ of _____
(distance) (direction) (nearest town)


WELL PURPOSE: None
(home, irrigation, municipal, industrial)

WELL COMPLETION DATA:

- (1) diameter (inches) 2"
 - (2) total depth (feet) 300'
 - (3) static water level (feet) 40 below above top of ground.
 - (4) casing PVC, 290'
(material) (depth)
(size) if telescope see back.
 - (5) screen 10', 290'
(length) (depth to top)
2", PVC
(size) (material)
 - (6) pump One, 15
(HP) (yield gpm)
Ch
(type power)
 - (7) electric log no
(yes or no)
- (organization running log)

(8) how well bottom plugged
2' back wash data


DRILLERS REMARKS:
none

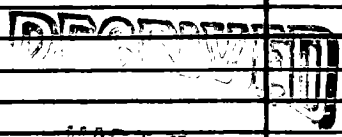

MAR 17 1976

If well telescopes please sketch and show depths.

GROUND LEVEL

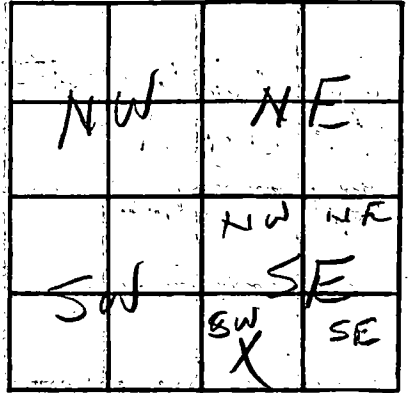

SECTION _____

Please indicate well location X.

ADDITIONAL INFORMATION

If more than one screen, show locations of each on sketch.