

Harrison
 C 132
 10-15-75

MISSISSIPPI
 BOARD OF WATER COMMISSIONERS
 416 North State Street
 Jackson, Mississippi 39201

CODED

WATER WELL DRILLERS LOG

Oct. 15 1975 McMill well works Harrison
 date well completed firm name county well located

LANDOWNER: <u>Lula Garner</u>	description of formations encountered	from	to
<u>pt. 2, Box 168</u> <u>Lancien, Miss.</u> (mailing address)			
	<u>clay</u>	<u>0</u>	<u>20</u>
	<u>C. Sand</u>	<u>20</u>	<u>85</u>

WELL LOCATION:
 sec. 13 T 5 N R 11 E ¹³⁵
1 miles NE of Lancien
 (distance) (direction) (nearest town)

CODED

WELL PURPOSE: Home
 (home, irrigation, municipal, industrial)

WELL COMPLETION DATA:

- (1) diameter (inches) 2"
- (2) total depth (feet) 85
- (3) static water level (feet) 31' ^{below} _{above} top of ground.
- (4) casing plastic, 75'
(material) (depth)
- If telescope see back.
(size)
- (5) screen 10',
(length) (depth to top)
- 2",
(size) (material)
- (6) pump 1 12
(HP) (yield gpm)
- electric
(type power)
- (7) electric log no
(yes or no)

 (organization running log)

(8) how well bottom plugged sand
shark


DRILLERS REMARKS:

NOV 20 1975

MISS. Bd. of Water Comm

If well telescopes please sketch and show depths.

GROUND LEVEL

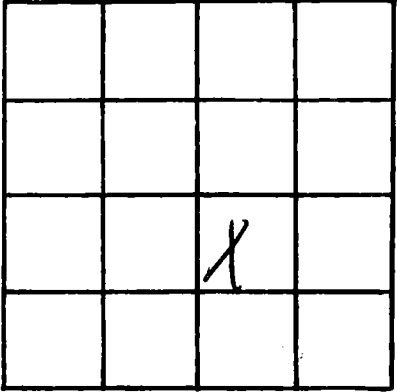

SECTION 13

Please indicate well location X.

ADDITIONAL INFORMATION

If more than one screen, show locations of each on sketch.