

HARRISON
C 136
11-12-75

MISSISSIPPI
BOARD OF WATER COMMISSIONERS
416 North State Street
Jackson, Mississippi 39201

CODED

WATER WELL DRILLERS LOG

COASTAL DRILLING & SERVICE CO. *Hammond*

11/12 1975
date well completed

ROUTE 1 BOX 618

county well located

LANDOWNER: *J. Ripston* BHO

Description of formations encountered

from to

pt 4 Baf 702
Spot, Min 39501
(mailing address)

Top Soil	1	3
Red Clay	3	50
White Sand	50	85
Loam	85	90
Soft Blue Clay	90	150
Dark Blue	150	200
White Sand	200	230
Dark Blue Clay	230	260
fine water Sand	260	292
Coarse water Sand	292	323

WELL LOCATION:
sec *36* T *5* N R *11* E
S W
Togus Creek
(distance) (direction) (nearest town)

WELL PURPOSE: *home*
(home, irrigation, municipal, industrial)

WELL COMPLETION DATA:

- (1) diameter (inches) *2"*
- (2) total depth (feet) *323*
- (3) static water level (feet) *100* below above top of ground.
- (4) casing *PVC*, *313'*
(material) (depth)
(size) If telescope see back.
- (5) screen *10'*, *313'*
(length) (depth to top)
2", *PVC*
(size) (material)
- (6) pump *1 1/2*, *8*
(HP) (yield gpm)
Ele
(type power)
- (7) electric log *no*
(yes or no)
(organization running log)

(8) how well bottom plugged
2 inch West Valve


DRILLERS REMARKS:
none

MAR 17 1976

MISS. BD. OF WATER COMMISSIONERS

If well telescopes please sketch and show depths.

GROUND LEVEL

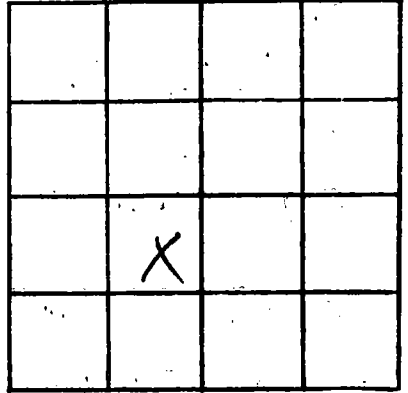

SECTION _____

Please indicate well location X.

ADDITIONAL INFORMATION

If more than one screen, show locations of each on sketch.