

Harrison
C 137
11-14-75

MISSISSIPPI
 BOARD OF WATER COMMISSIONERS
 416 North State Street
 Jackson, Mississippi 39201

CODED

WATER WELL DRILLERS LOG

14 NOV 1975 BOYNT WELL CO HARRISON
 date well completed firm name county well located

LANDOWNER: E.H. LEE
PO BOX 545-E
SAUCIER, Miss.
 (mailing address)

WELL LOCATION:
 sec 30 T 5 S R 11 W
3 miles S of SAUCIER
 (distance) (direction) (nearest town)

WELL PURPOSE: HOME
 (home, irrigation, municipal, industrial)

WELL COMPLETION DATA:

(1) diameter (inches) 2

(2) total depth (feet) 328

(3) static water level (feet) 42 below top of ground.

(4) casing PVC, 323
 (material) (depth)

— If telescope see back.
 (size)

(5) screen 5', 323
 (length) (depth to top)

009, PVC
 (size) (material)

(6) pump 1 10
 (HP) (yield gpm)


ELECTRIC
 (type power)

(7) electric log NO
 (yes or no)

(organization running log)

(8) how well bottom plugged Metal
Sand Shark

description of formations encountered	from	to
RED CLAY	0	10
WHITE SAND	10	12
RED CLAY	12	99
FINE SAND	99	119
BLUE CLAY	119	220
FINE SAND	220	230
BLUE CLAY	230	258
Good SAND	258	328

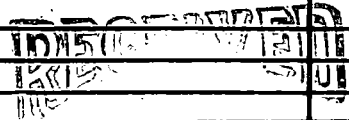

DEC 17 1975

MISS. BU. OF WATER COMM.

DRILLERS REMARKS:

If well telescopes please sketch and show depths.

GROUND LEVEL

		X	

SECTION 30

Please indicate well location X.

ADDITIONAL INFORMATION

If more than one screen, show locations of each on sketch.