

Harrison  
C 138  
12/1/75

MISSISSIPPI  
 BOARD OF WATER COMMISSIONERS  
 416 North State Street  
 Jackson, Mississippi 39201

**CODED**

WATER WELL DRILLERS LOG

1 DEC 1975 BAYENT WELL CO. HARRISON  
 date well completed firm name county well located

LANDOWNER: T & M INC  
SOUTHSHORE DR.  
B. Toxi, Ms.  
 (mailing address)

WELL LOCATION:  
 sec 26 T 5 S R 11 W  
11 miles N of Gulfport  
 (distance) (direction) (nearest town)

WELL PURPOSE: HOME  
 (home, irrigation, municipal, industrial)

description of formations encountered	from	to
Red clay	0	19
COARSE WHITE SAND	19	64
CLAY SAND	64	141
BIKE CLAY	141	152
FINE SAND	152	164
BIKE CLAY (CODE)	164	201
SAND STONE 6"	201	201 1/2
FINE SAND	201	225
BIKE CLAY	225	303
Good SAND	303	329

WELL COMPLETION DATA:

(1) diameter (inches) 2

(2) total depth (feet) 329

(3) static water level (feet) 146 below top of ground.

(4) casing PVC 303  
 (material) (depth)  
 (size) If telescope see back.

(5) screen 5' 303  
 (length) (depth to top)  
209 PVC  
 (size) (material)


(6) pump 1 1/2 10  
 (HP) (yield gpm)  
Electric  
 (type power)

(7) electric log No  
 (yes or no)

(organization running log)

(8) how well bottom plugged: Met  
Sand Sparker

DRILLERS REMARKS:

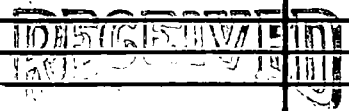

DEC 17 1975

If well telescopes please sketch and show depths.

GROUND LEVEL

		*	

SECTION 26

Please indicate well location X.

ADDITIONAL INFORMATION

If more than one screen, show locations of each on sketch.