

HARRISON
 C 139
 2-12-76

MISSISSIPPI
 BOARD OF WATER COMMISSIONERS
 416 North State Street
 Jackson, Mississippi 39201

CODED

WATER WELL DRILLERS LOG

2-12-76 ¹³⁵ ~~Pernell Anderson~~ Warrison
 date well completed firm name county well located

LANDOWNER:
James Hartman
 (mailing address)
 WELL LOCATION:
 sec 19 T 5 S R 11
3 miles S of Sanders
 (distance) (direction) (nearest town)

| description of formations encountered | from | to |
|---------------------------------------|------|-----|
| Top Soil | 0 | 4 |
| Red Clay | 4 | 12 |
| White Clay | 12 | 33 |
| Fin Sand | 35 | 88 |
| Blue Clay | 88 | 103 |
| Coarse Sand | 103 | 117 |

WELL PURPOSE: HOME
 (home, irrigation, municipal, industrial)

WELL COMPLETION DATA:
 (1) diameter (inches) 2"
 (2) total depth (feet) 117'
 (3) static water level (feet) 32' below top of ground
 (4) casing Plastic, 117'
 (material) (depth)
 (size) if telescope see back.
 (5) screen 5' 117'
 (length) (depth to top)
2" Plastic
 (size) (material)
 (6) pump 1 10
 (HP) (yield gpm)
Elect
 (type power)
 (7) electric log nee
 (yes or no)
 (organization running log)
 (8) how well bottom plugged
Capped

RECEIVED 50


MAR 3 1976

DRILLERS REMARKS:

MISS. BD. OF WATER COMM

If well telescopes please sketch and show depths.

GROUND LEVEL

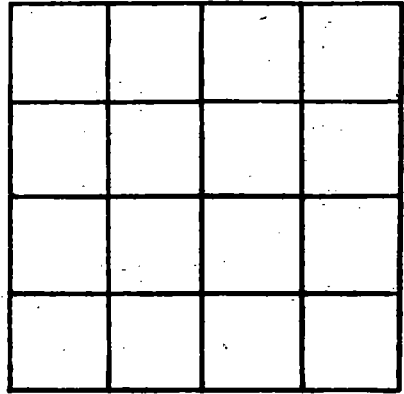

SECTION _____

Please indicate well location X.

ADDITIONAL INFORMATION

If more than one screen, show locations of each on sketch.