

HARRISON
C. 140
2/21/76

MISSISSIPPI
BOARD OF WATER COMMISSIONERS
416 North State Street
Jackson, Mississippi 39201

CODED

WATER WELL DRILLERS LOG

2/21 1976 Genevill Well Work Harrison
date well completed firm name county well located

LANDOWNER Elvin Dyper
Laurin Community
(mailing address)

description of formations encountered	from	to
red soft clay	0	80
hard white clay	80	140
hard blue clay	140	200
small blue gravel	200	325
W/ sand		

WELL LOCATION:
sec. 20 T. 5 R. 14
1/2 miles SE of Sociedad
(distance) (direction) (nearest town)

WELL PURPOSE: home
(home, irrigation, municipal, industrial)

- WELL COMPLETION DATA:
- (1) diameter (inches) 2"
 - (2) total depth (feet) 325
 - (3) static water level (feet) 45 below top of ground.
 - (4) casing PVC, 325
(material) (depth)
2 If telescope see back.
(size)
 - (5) screen 10', 315
(length) (depth to top)
2, PVC
(size) (material)
 - (6) pump 1, 8-12
(HP) (yield gpm)
Elec
(type power)
 - (7) electric log W
(yes or no)
(organization running log)
 - (8) how well bottom plugged sand
about


DRILLERS REMARKS: started
Driller had to move
for Board of Health

RECEIVED
FEB 11 1977

MISS. BD. OF WATER COMM

If well telescopes please sketch and show depths.

GROUND LEVEL

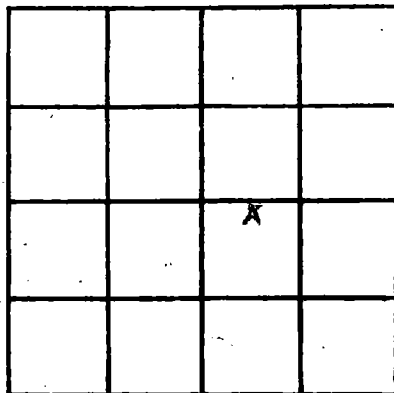

SECTION _____

Please indicate well location X.

ADDITIONAL INFORMATION

If more than one screen, show locations of each on sketch.