

HARRISON
C 141
2-27-76

MISSISSIPPI
BOARD OF WATER COMMISSIONERS
416 North State Street
Jackson, Mississippi 39201

CODED

WATER WELL DRILLERS LOG

2-27
date well completed

135

1976 *Gene Anderson*
firm name

Harrison
county well located

LANDOWNER:	description of formations encountered	from	to
<i>Jerry Middleton</i>	<i>Top Soil</i>	<i>0</i>	<i>4</i>
(mailing address)	<i>Fine Sand</i>	<i>4</i>	<i>38</i>
WELL LOCATION:	<i>Clay</i>	<i>38</i>	<i>270</i>
sec. <i>17 T 5 S R 11 E</i>	<i>Fine Sand</i>	<i>270</i>	<i>300</i>
<i>4</i> miles <i>SE</i> of <i>Scudder</i>	<i>Coarse Sand</i>	<i>300</i>	<i>310</i>
(distance) (direction) (nearest town)			
WELL PURPOSE: <i>HOME</i>			
(home, irrigation, municipal, industrial)			
WELL COMPLETION DATA:			
(1) diameter (inches) <i>2"</i>			
(2) total depth (feet) <i>310'</i>			
(3) static water level (feet) <i>42'</i> below top of ground			
(4) casing <i>Plastic 305'</i>			
(material) (depth)			
_____ If telescope see back.			
(size)			
(5) screen <i>5' 305'</i>			
(length) (depth to top)			
<i>2" Plastic</i>			
(size) (material)			
(6) pump <i>1 8</i>			
(HP) (yield gpm)			
<i>Elect</i>			
(type power)			
(7) electric log <i>no</i>			
(yes or no)			


(organization running log)			
(8) how well bottom plugged <i>Backwash Valve</i>			
DRILLERS REMARKS:			

RECEIVED
MAR 3 1976

MISS. BD. OF WATER COMMA

If well telescopes please sketch and show depths.

GROUND LEVEL

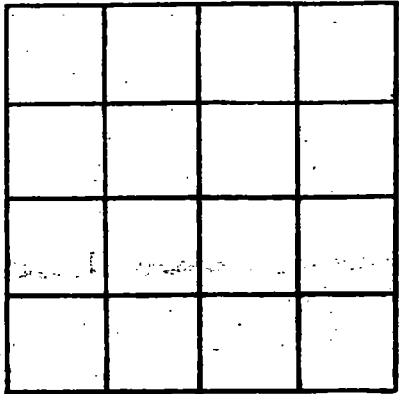

SECTION _____

Please indicate well location X.

ADDITIONAL INFORMATION

If more than one screen, show locations of each on sketch.