

HARRISON
C 142
4-3-76

MISSISSIPPI
 BOARD OF WATER COMMISSIONERS
 416 North State Street
 Jackson, Mississippi 39201

CODED

WATER WELL DRILLERS LOG

4376 19 R. J. Mooker HARRISON
 date well completed firm name county well located

LANDOWNER: C. GIFFORD
EAST ADAM RD
Shuckers, MS
 (mailing address)
 WELL LOCATION:
 sec. 20 T. S N. R. 11 E
1 1/2 miles E of Shuckers
 (distance) (direction) (nearest town)

description of formations encountered	from	to
TOP SOIL	0	10
Sandy clay	10	25
white + blue clay	25	60
Red clay	60	340
FINE Blue Sand	340	380
Med Blue Sand	380	400

WELL PURPOSE:
 Home Irrigation, municipal, industrial

WELL COMPLETION DATA:
 (1) diameter (inches) 2"
 (2) total depth (feet) 400'
 (3) static water level (feet) 46' (below/above top of ground)
 (4) casing PVC 390'
 (material) (depth)
 (size) if telescope see back.
 (5) screen 10' 390'
 (length) (depth to top)
2" PVC
 (size) (material)
 (6) pump 1 8
 (HP) (yield gpm)
E
 (type power)
 (7) electric log _____
 (yes or no)

 (organization running log)
 (8) how well bottom plugged _____
100% sand


DRILLERS REMARKS: _____

MAY 13 1976

MISS. BD. OF WATER COMMISSIONERS

If well telescopes please sketch and show depths.

GROUND LEVEL

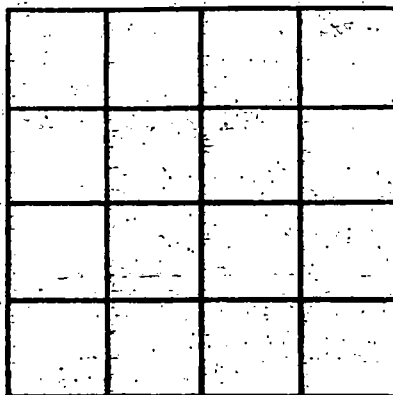

SECTION _____

Please indicate well location X.

ADDITIONAL INFORMATION

If more than one screen, show locations of each on sketch.