

HARRISON
C 143
4-6-76

MISSISSIPPI
BOARD OF WATER COMMISSIONERS
416 North State Street
Jackson, Mississippi 39201

CODED

WATER WELL DRILLERS LOG

4-6 1976 M&B Drilling Co. Harrison
date well completed firm name county well located


LANDOWNER: <u>Billy Schnewitz</u>	description of formations encountered	from	to
<u>M.A.</u>			
<u>Saucier, Miss.</u> (mailing address)	<u>Surface</u>	<u>0</u>	<u>3</u>
	<u>Brown Clay</u>	<u>3</u>	<u>10</u>
	<u>Red Clay</u>	<u>10</u>	<u>30</u>
	<u>Sand</u>	<u>30</u>	<u>45</u>
	<u>White Clay</u>	<u>45</u>	<u>70</u>
	<u>Sand</u>	<u>70</u>	<u>80</u>
	<u>Blue Clay</u>	<u>80</u>	<u>105</u>
	<u>Tripe Sand</u>	<u>105</u>	<u>195</u>
	<u>Blue Clay</u>	<u>195</u>	<u>270</u>
	<u>Grey Sand</u>	<u>270</u>	<u>315</u>
WELL LOCATION: sec. <u>17</u> T <u>5</u> S R <u>11</u> E <u>2</u> miles <u>SE</u> of <u>Saucier</u> (distance) (direction) (nearest town)			
WELL PURPOSE: <u>Home</u> (home, irrigation, municipal, industrial)			
WELL COMPLETION DATA:			
(1) diameter (inches) <u>2</u>			
(2) total depth (feet) <u>315</u>			
(3) static water level (feet) <u>31</u> below top of ground			
(4) casing <u>PVC</u> <u>315</u> (material) (depth)			
<u>2"</u> If telescope see back (size)			
(5) screen <u>10ft</u> <u>305</u> (length) (depth to top)			
<u>2"</u> <u>PVC</u> (size) (material)			
(6) pump <u>1</u> <u>10</u> (HP) (yield gpm)			
<u>110V 1Ø</u> (type power)			
(7) electric log <u>No</u> (yes or no)			
(organization running log)			
(8) how well bottom plugged <u>2" Cap</u>			
DRILLERS REMARKS:			

RECORDED
APR 19 1976

MISSISSIPPI BOARD OF WATER COMMISSIONERS

If well telescopes please sketch and show depths.

GROUND LEVEL

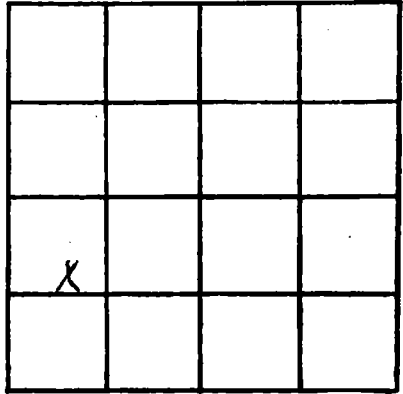

SECTION 17

Please indicate well location X.

ADDITIONAL INFORMATION

If more than one screen, show locations of each on sketch.