

HARRISON
C 144
4/20/76

MISSISSIPPI
 BOARD OF WATER COMMISSIONERS
 416 North State Street
 Jackson, Mississippi 39201

CODED

WATER WELL DRILLERS LOG


4-20-76 19 76 R. V. Moore HARRISON
 date well completed firm name county well located

LANDOWNER: <u>R. Williams</u> <u>FAIRLEY RD</u>	description of formations encountered	from	to
<u>Shacler</u> (mailing address)	<u>TOP SOIL</u> CODED	<u>0</u>	<u>10</u>
WELL LOCATION: sec. <u>7</u> T <u>S</u> N <u>3</u> R <u>11</u> E <u>1/2</u> miles <u>E</u> of <u>Shacler</u> (distance) (direction) (nearest town)	<u>White Cherty</u>	<u>10</u>	<u>40</u>
WELL PURPOSE: (home, Irrigation, municipal, Industrial)	<u>Red Silty</u>	<u>40</u>	<u>80</u>
WELL COMPLETION DATA:	<u>Blue Clay</u>	<u>80</u>	<u>240</u>
(1) diameter (inches) <u>2"</u>	<u>Graty Sand</u>	<u>240</u>	<u>320</u>
(2) total depth (feet) <u>320'</u>			
(3) static water level (feet) <u>70'</u> below top of ground			
(4) casing <u>Pvc</u> <u>305'</u> (material) (depth)			
(5) screen <u>18"</u> <u>205'</u> (length) (depth to top)			
(6) pump <u>2"</u> <u>Pvc</u> (size) (material)			
(7) electric log <u>E</u> (yes or no)			
(8) how well bottom plugged <u>Drill Hole</u>			
DRILLERS REMARKS:			

RECEIVED
MAY 13 1976

If well telescopes please sketch and show depths.

GROUND LEVEL

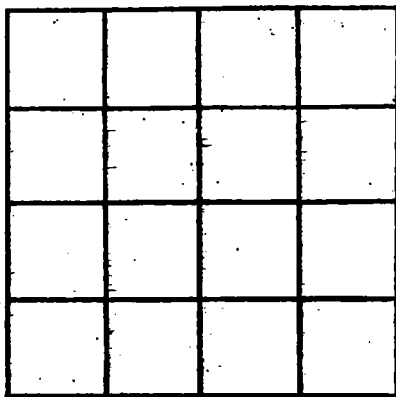

SECTION _____

Please indicate well location X.

ADDITIONAL INFORMATION

If more than one screen, show locations of each on sketch.