

HARRISON
C. 145
6-25-76

MISSISSIPPI
 BOARD OF WATER COMMISSIONERS
 416 North State Street
 Jackson, Mississippi 39201

CODED

WATER WELL DRILLERS LOG

June 25 1976 BRYANT WELL CO HARRISON
 (date well completed) (firm name) (county well located)

LANDOWNER: David Nobles
P.O. Box 171 R+1
Saucier, ms
 (mailing address)

WELL LOCATION:
 sec 29 T 5 N R 11 E
12 miles N of APT
 (distance) (direction) (nearest town)

WELL PURPOSE: Home
 (home, irrigation, municipal, industrial)

WELL COMPLETION DATA:

(1) diameter (inches) 2"

(2) total depth (feet) 298

(3) static water level (feet) _____ below
 top of ground. above

(4) casing PVC, 298,
 (material) (depth)

_____ If telescope see back.
 (size)

(5) screen 5, 293
 (length) (depth to top)

10, PVC
 (size) (material)

(6) pump 1 10
 (HP) (yield gpm)

ELECT
 (type power)

(7) electric log _____ No
 (yes or no)

_____ (organization running log)

(8) how well bottom plugged MATERIAL
SAND SHANK

description of formations encountered	from	to
Red Clay	0	7
White Sand	7	21
White Clay	21	44
Fine Sand	44	69
Blue Clay CODED	69	92
Fine Sand	92	115
Blue Clay	115	163
Fine Sand	163	168
Blue Clay	168	226
Fine Sand	226	231
Blue Clay	231	273
Good Sand	273	298

RECEIVED


JUL 15 1976

DRILLERS REMARKS:
Drilled by C.M. Bryant Jr

MISS. BD. OF WATER COMM

If well telescopes please sketch and show depths.

GROUND LEVEL

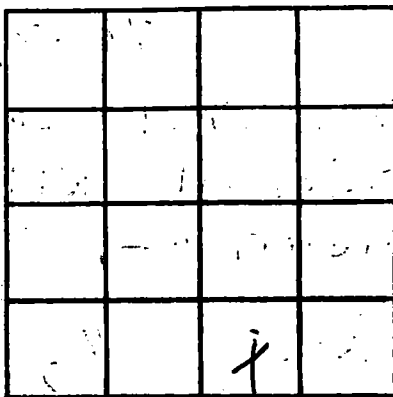

SECTION 29

Please indicate well location X.

ADDITIONAL INFORMATION

If more than one screen, show locations of each on sketch.