

HARRISON
 C 150
 11/24/76

MISSISSIPPI
 BOARD OF WATER COMMISSIONERS
 416 North State Street
 Jackson, Mississippi 39201

CODED

WATER WELL DRILLERS LOG

11/29 1976 Pineville Well at Harrison
 (date well completed) (firm name) (county well located)

LANDOWNER: Barry Koch
 Laurier Luis
 (mailing address)
 WELL LOCATION:
 sec. 7 T. 5 S. R. 11 E.
 0 miles E of Prairie
 (distance) (direction) (nearest town)

description of formations encountered	from	to
Red clay	0	80
White patty type clay	80	130
White pipe clay	130	260
Coar. water rd.	260	290

WELL PURPOSE:
 (home, irrigation, municipal, industrial)

CODED

WELL COMPLETION DATA:
 (1) diameter (inches) 2"
 (2) total depth (feet) 290
 (3) static water level (feet) 45 below top of ground.
 (4) casing PVC, 280 (depth)
 2 (size) if telescope see back.
 (5) screen 10, 280 (length) (depth to top)
 2 PVC (size) (material)
 (6) pump 1 (HP) 9 (yield gpm)
 Elec (type power)
 (7) electric log No (yes or no)
 (organization running log)
 (8) how well bottom plugged sand

RECEIVED
 MAR - 6 1978


DRILLERS REMARKS:

This well was drilled for Balboa Service

MISS. BD: 41

If well telescopes please sketch and show depths.

GROUND LEVEL

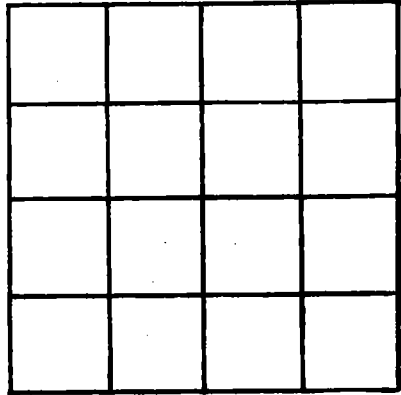

SECTION _____

Please indicate well location X.

ADDITIONAL INFORMATION

If more than one screen, show locations of each on sketch.