

HARRISON  
C-153  
2/12/77

MISSISSIPPI  
 BOARD OF WATER COMMISSIONERS  
 416 North State Street  
 Jackson, Mississippi 39201

CODED

WATER WELL DRILLERS LOG

Feb 12 19 77 BRYANT Well Co. HARRISON  
 date well completed firm name county well located

LANDOWNER: Jimmy Morris  
206 Wilson Blvd.  
RT 4 Lefloist  
 (mailing address)

WELL LOCATION:  
 sec. 30 T 5 N R 11 E  
4 miles S of Sauier  
 (distance) (direction) (nearest town)

WELL PURPOSE: Home  
 (home, irrigation, municipal, industrial)

WELL COMPLETION DATA:

(1) diameter (inches) 4' x 2"  
 (2) total depth (feet) 343  
 (3) static water level (feet) 42 below top of ground.  
 (4) casing PVC 323"  
 (material) (depth)  
4' x 2"  
 (size) If telescope see back.  
 (5) screen 20' 323"  
 (length) (depth to top)  
010 PVC  
 (size) (material)  
 (6) pump \_\_\_\_\_ (HP) \_\_\_\_\_ (yield gpm)  
 \_\_\_\_\_ (type power)  
 (7) electric log W  
 (yes or no)  
 \_\_\_\_\_ (organization running log)  
 (8) how well bottom plugged Metal  
SAND STACK

description of formations encountered	depth	
	from	to
<u>red clay</u>	<u>0</u>	<u>35</u>
<u>sand</u>	<u>35</u>	<u>36</u>
<u>clay</u>	<u>36</u>	<u>81</u>
<u>sand</u>	<u>81</u>	<u>89</u>
<u>clay</u>	<u>89</u>	<u>115</u>
<u>sand</u>	<u>115</u>	<u>131</u>
<u>clay</u>	<u>131</u>	<u>194</u>
<u>sand</u>	<u>194</u>	<u>200</u>
<u>clay</u>	<u>210</u>	<u>286</u>
<u>good sand</u>	<u>286</u>	<u>343</u>

RECEIVED  
 MAR - 7 1977

MISS. BD. OF WATER COMM.

DRILLERS REMARKS:

If well telescopes please sketch and show depths.

GROUND LEVEL


4" PVC 180'  
Bell reader 180'

2" PVC

323'

2" PVC screen

343'

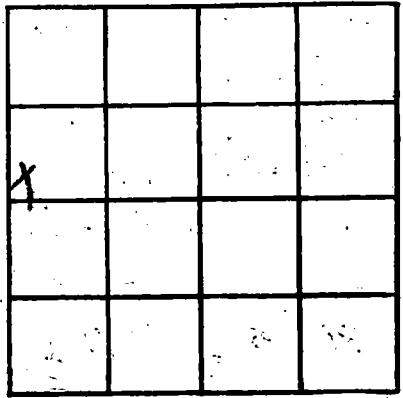

SECTION 30

Please indicate well location X.

ADDITIONAL INFORMATION

If more than one screen, show locations of each on sketch.