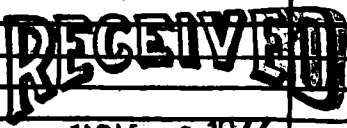


Harrison  
C-156  
9-16-77

MISSISSIPPI  
 BOARD OF WATER COMMISSIONERS  
 416 North State Street  
 Jackson, Mississippi 39201

WATER WELL DRILLERS LOG

9-16 1977 Samuel Anderson Harrison  
 date well completed firm name county well located

LANDOWNER:	description of formations encountered	from	to
<u>Alfred Lott</u> (mailing address)	<u>Top Soil</u>	<u>0</u>	<u>2</u>
WELL LOCATION: sec. <u>13</u> T. <u>5</u> N. R. <u>11</u> E <u>5</u> miles <u>E</u> of <u>Sauces</u> (distance) (direction) (nearest town)	<u>Sandy Clay</u>	<u>2</u>	<u>36</u>
WELL PURPOSE: <u>HOME</u> (home, irrigation, municipal, industrial)	<u>Coarse Sand</u>	<u>36</u>	<u>80</u>
WELL COMPLETION DATA: (1) diameter (inches) <u>2"</u> (2) total depth (feet) <u>80'</u> (3) static water level (feet) <u>52</u> below top of ground (4) casing <u>Plastic</u> , <u>75'</u> (material) (depth) (size) If telescope see back. (5) screen <u>5'</u> , <u>75'</u> (length) (depth to top) <u>2"</u> , <u>Plastic</u> (size) (material) (6) pump <u>10</u> (HP) (yield gpm) <u>Elect</u> (type power) (7) electric log <u>no</u> (yes or no) (organization running log) (8) how well bottom plugged <u>Capped</u>			
DRILLERS REMARKS: <u>See</u>	 NOV - 8 1977		

If well telescopes please sketch and show depths.

GROUND LEVEL


SECTION \_\_\_\_\_

Please indicate well location X.

ADDITIONAL INFORMATION

If more than one screen, show locations of each on sketch.