

HARRISON
 C-166
 2-24-78

MISSISSIPPI
 BOARD OF WATER COMMISSIONERS
 416 North State Street
 Jackson, Mississippi 39201

CODED

WATER WELL DRILLERS LOG

Feb. 24 1978 Duncan Well Drilling Harrison
 date well completed firm name county well located

LANDOWNER: Charlie M. Johnson
Rt. 1 Box 376
Saucier, Ms. 39574
 (mailing address)

Description of formations encountered	from	to
top sand	0	25
Blue clay	25	200
fine sand	200	235
Course sand	235	252

WELL LOCATION:
 sec 8 T 5 N R 11 E
2 miles South of Saucier
 (distance) (direction) (nearest town)

WELL PURPOSE: Home
 (home, irrigation, municipal, industrial)

CODED

- WELL COMPLETION DATA:
- (1) diameter (inches) 2"
 - (2) total depth (feet) 252'
 - (3) static water level (feet) 100 ^{below} _{above} top of ground.
 - (4) casing pvc, 242'
 (material) (depth)
 - 10' If telescope see back.
 (size)
 - (5) screen 10', 242'
 (length) (depth to top)
 - 2', pvc sch. 40
 (size) (material)
 - (6) pump 1, 4
 (HP) (yield gpm)
 - electric
 (type power)
 - (7) electric log NO
 (yes or no)

(organization running log)

(8) how well bottom plugged sand
mark

DRILLERS REMARKS:


RECEIVED

AUG 11 1978

MISS. BD. OF WATER COMMISSIONERS

If well telescopes please sketch and show depths.

GROUND LEVEL

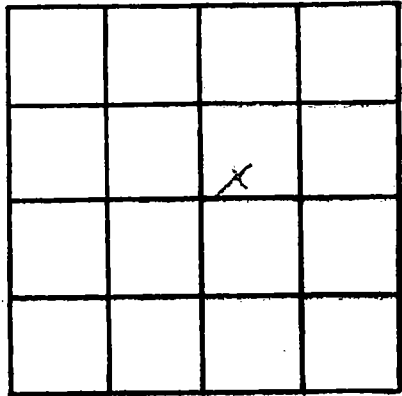

SECTION 18

Please indicate well location X.

ADDITIONAL INFORMATION

If more than one screen, show locations of each on sketch.