

Harrison
 C-169
 2-28-79

MISSISSIPPI
 BOARD OF WATER COMMISSIONERS
 416 North State Street
 Jackson, Mississippi 39201

CODED

WATER WELL DRILLERS LOG

Feb. 28 1979 Swanwick Well Drilling Harrison
 date well completed firm name county well located

| LANDOWNER: <u>Richard Aiken</u> | Description of formations encountered | from | to |
|--|---------------------------------------|------------|------------|
| <u>RR #1</u> | <u>Red Clay</u> | <u>0</u> | <u>10</u> |
| <u>Saucier, Mo. 39574</u> (mailing address) | <u>White Clay</u> | <u>10</u> | <u>100</u> |
| | <u>Blue Clay</u> | <u>100</u> | <u>205</u> |
| | <u>Fine Sand</u> | <u>205</u> | <u>242</u> |
| | <u>Coarse Sand</u> | <u>242</u> | <u>252</u> |

WELL LOCATION:
 sec. 30 T. 48 S. R. 11 E. W
2 miles S. of McKenry
 (distance) (direction) (nearest town)

WELL PURPOSE: Home
 (home, irrigation, municipal, industrial)

- WELL COMPLETION DATA:
- (1) diameter (inches) 2 1/2
 - (2) total depth (feet) 252'
 - (3) static water level (feet) 100' below above top of ground.
 - (4) casing PVC, 242'
 (material) (depth)
 - _____ if telescope see back.
 (size)
 - (5) screen 10', 242
 (length) (depth to top)
 - 2", PVC
 (size) (material)
 - (6) pump 1 5
 (HP) (yield gpm)
 - electric
 (type power)
 - (7) electric log _____
 (yes or no)
 - _____ (organization running log)
 - (8) how well bottom plugged Sand

CODED

Miss. Board of Water Comm.


JUN - 5 1979

DRILLERS REMARKS:

RECEIVED

If well telescopes please sketch and show depths.

GROUND LEVEL

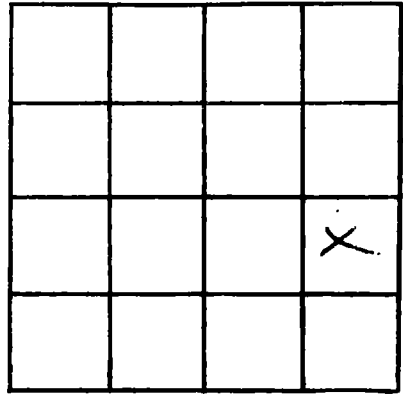

SECTION 30

Please indicate well location X.

ADDITIONAL INFORMATION

If more than one screen, show locations of each on sketch.