

HARRISON
C-170
5-19-79

MISSISSIPPI
BOARD OF WATER COMMISSIONERS
416 North State Street
Jackson, Mississippi 39201

CODED

WATER WELL DRILLERS LOG

May 19 1979 Success Well Drilling Harrison
date well completed firm name county well located

LANDOWNER: <u>Myra Sauer Cordle</u>	Description of formations encountered	from	to
<u>Rt. 2 Box 172</u>	<u>Clay</u>	<u>0</u>	<u>40</u>
<u>Sauvies, Mo. 39574</u> (mailing address)	<u>Sand</u>	<u>40</u>	<u>80</u>
WELL LOCATION: <u>2</u> miles <u>S.E.</u> of <u>Jacobs</u> (distance) (direction) (nearest town)	<u>White clay</u>	<u>80</u>	<u>200</u>
WELL LOCATION: <u>2</u> miles <u>S.E.</u> of <u>Jacobs</u> (distance) (direction) (nearest town)	<u>Blue clay</u>	<u>200</u>	<u>400</u>
WELL LOCATION: <u>2</u> miles <u>S.E.</u> of <u>Jacobs</u> (distance) (direction) (nearest town)	<u>fine sand</u>	<u>400</u>	<u>440</u>
WELL LOCATION: <u>2</u> miles <u>S.E.</u> of <u>Jacobs</u> (distance) (direction) (nearest town)	<u>Coarse sand</u>	<u>440</u>	<u>450</u>
WELL PURPOSE: <u>Home</u> (home, irrigation, municipal, industrial)			
WELL COMPLETION DATA:			
(1) diameter (inches) <u>2"</u>			
(2) total depth (feet) <u>452'</u>			
(3) static water level (feet) <u>160'</u> ^{below} top of ground.			
(4) casing <u>PVC</u> <u>442'</u> (material) (depth)			
_____ (size) if telescope see back.			
(5) screen <u>10'</u> <u>442'</u> (length) (depth to top)			
_____ (size) <u>PVC</u> (material)			
(6) pump <u>1 1/2</u> <u>5</u> (HP) (yield gpm)			
_____ (type power) <u>electric</u>			
(7) electric log _____ (yes or no)			
_____ (organization running log)			
(8) how well bottom plugged <u>Sand</u>			

DRILLERS REMARKS: _____			

CODED


Miss. Board of Water Comm.

JUN 1979

RECEIVED

If well telescopes please sketch and show depths.

GROUND LEVEL

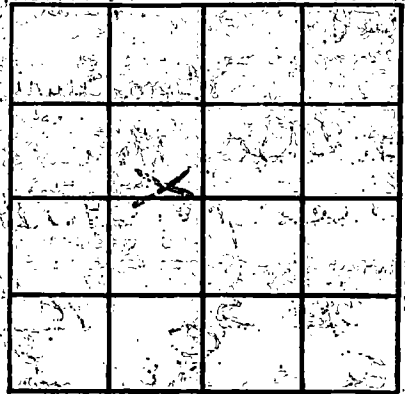

SECTION 24

Please indicate well location X.

ADDITIONAL INFORMATION

If more than one screen, show locations of each on sketch.