

HARRISON
 C 175
 7-14-79

MISSISSIPPI
 BOARD OF WATER COMMISSIONERS
 416 North State Street
 Jackson, Mississippi 39201
 WATER WELL DRILLERS LOG

CODED

7-14 1979 Badon Pump and Harrison
 date well completed firm name county well located

well source, inc.

LANDOWNER:	description of formations encountered	from	to
<u>William W. Maggard</u> <u>Rt 1, Box 13</u> <u>Pound, Va 24279</u> (mailing address)	<u>Red clay</u>	<u>0</u>	<u>80</u>
	<u>Gravel</u>	<u>80</u>	<u>100</u>
	<u>sand + gravel</u>	<u>100</u>	<u>120</u>
	<u>sand</u>	<u>120</u>	<u>130</u>
	<u>Blue clay</u>	<u>130</u>	<u>210</u>
	<u>sand</u>	<u>210</u>	<u>220</u>
	<u>Blue clay</u>	<u>220</u>	<u>300</u>
	<u>sand</u>	<u>300</u>	<u>330</u>
	<u>clay</u>	<u>330</u>	<u>340</u>
WELL LOCATION: sec. <u>23</u> T. <u>5</u> N. R. <u>11</u> E. <u>4</u> miles <u>SE</u> of <u>Saucier</u> (distance) (direction) (nearest town)			
WELL PURPOSE: <u>Home</u> (home, irrigation, municipal, industrial)			
WELL COMPLETION DATA: (1) diameter (inches) <u>2"</u>			
(2) total depth (feet) <u>340'</u>			
(3) static water level (feet) <u>115</u> ^{below} above top of ground.			
(4) casing <u>PVC</u> , total, (material) (depth) <u>2"</u> (size) if telescope see back.			
(5) screen <u>10 ft</u> , <u>330'</u> (length) (depth to top)			
<u>2"</u> , <u>ARC</u> <u>mesh</u> <u>under</u> (size) (material)			
(6) pump <u>1</u> <u>6</u> (HP) (yield gpm)			
<u>220V 1Ø</u> (type power)			
(7) electric log <u>NO</u> (yes or no)			
(8) how well bottom plugged <u>2" sand wash</u>			
DRILLERS REMARKS: <u>10 ft tail pipe</u> <u>below screen</u>			

CODED


Miss. Board of Water Comm.

JUL 30 1979

RECEIVED

If well telescopes please sketch and show depths.

GROUND LEVEL

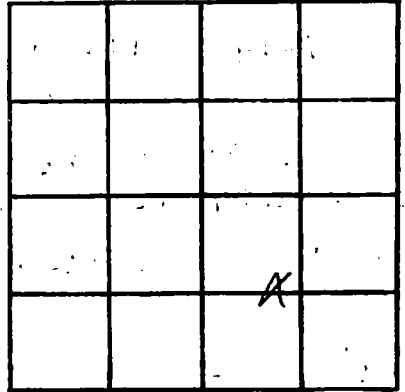

SECTION 25

Please indicate well location X.

ADDITIONAL INFORMATION

If more than one screen, show locations of each on sketch.