

HARRISON
C 176
7-14-79

MISSISSIPPI
BOARD OF WATER COMMISSIONERS
416 North State Street
Jackson, Mississippi 39201

CODED

WATER WELL DRILLERS LOG

7-14 1979 Braden Pump and Harrison
date well completed firm name county well located
Well Set Inc.

LANDOWNER: C.D. Phillips
Rt. 2, Box 24-C
Saucier, MS 39574
(mailing address)

description of formations encountered	from	to
clay	0	18
sand	18	24
clay	24	60
clay sand	60	120
sand	120	150
blue clay	150	270
sand	270	340

WELL LOCATION:
sec 20 T 5 S R 11 E
3 miles SE of Saucier
(distance) (direction) (nearest town)

WELL PURPOSE: Home
(home, irrigation, municipal, industrial)

WELL COMPLETION DATA:

- (1) diameter (inches) 4" x 2"
- (2) total depth (feet) 340'
- (3) static water level (feet) 20 below top of ground.
- (4) casing PVC, total (material), (depth)
- 4" x 2" (size) if telescope see back.
- (5) screen 10 ft, 320 ft (length), (depth to top)
2" PVC 1008 unclad (size), (material)
- (6) pump 1/2 HP sub, 20 (HP), (yield gpm)
220V 1Ø (type power)
- (7) electric log NO (yes or no)
(organization running log)
- (8) how well bottom plugged 2" sand & gravel

CODED

Miss. Board of Water Comm

JUL 30 1979

RECEIVED

DRILLERS REMARKS:
10 ft. tail pipe below screen

If well telescopes please sketch and show depths.

GROUND LEVEL

4" sch 40 PVC

4" x 2" PVC
Bushing

2" sch 40 PVC

2" x 10'
PVC 100 mesh under bar


2" sch 40 PVC
2" sand shark

160 ft

320 ft

330 ft

340 ft

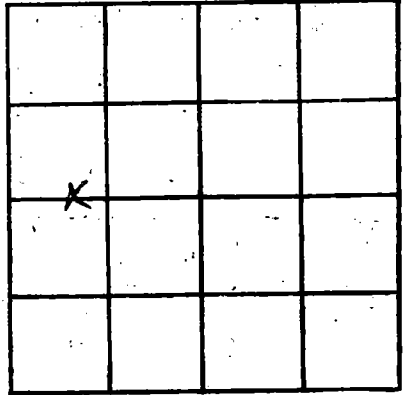

SECTION 20

Please indicate well location X.

ADDITIONAL INFORMATION

If more than one screen, show locations of each on sketch.