

Harrison
C 180
9-12-79

MISSISSIPPI
 BOARD OF WATER COMMISSIONERS
 416 North State Street
 Jackson, Mississippi 39201

CODED

WATER WELL DRILLERS LOG

9-12 1979 Roeden Pump + Well Harrison
 date well completed firm name county well located
Service, Inc.

LANDOWNERS Sherwood Goff Jr
Pt 2 Scarborough Rd
Saucier, Miss
 (mailing address)

description of formations encountered	from	to
clay	0	100
sandy	100	120
clay	120	170
sandy	170	200
clay	200	210
sandy	210	230
clay	230	260
sand	260	320

WELL LOCATION:
 sec 29 T 5 R 11
H miles S of Saucier
 (distance) (direction) (nearest town)

WELL PURPOSE: home
 (home, irrigation, municipal, industrial)

WELL COMPLETION DATA:

(1) diameter (inches) 2"

(2) total depth (feet) 320'

(3) static water level (feet) 45 below top of ground

(4) casing PVC, total
 (material) (depth)
2" If telescope see back.
 (size)

(5) screen 10 ft, 310'
 (length) (depth to top)
2", per PVC under bar
 (size) (material)

(6) pump 1 60
 (HP) (yield gpm)
270/16
 (type power)

(7) electric log NO
 (yes or no)

(organization running log)

CODED

(8) how well bottom plugged:
2" sand shark

DRILLERS REMARKS:
no tail pipe


DEPT. OF NATURAL RESOURCES
 BUREAU OF LAND & WATER RESOURCES

OCT 16 1979

RECEIVED

If well telescopes please sketch and show depths.

GROUND LEVEL

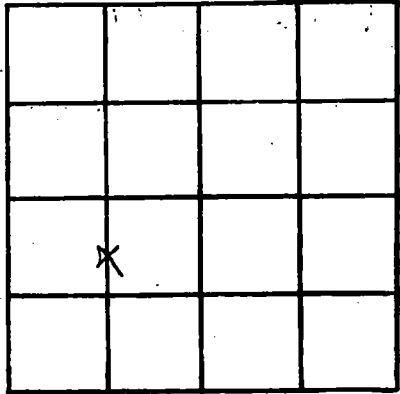

SECTION 29

Please indicate well location X.

ADDITIONAL INFORMATION

If more than one screen, show locations of each on sketch.