

Harrison
C. 181
9-22-79

MISSISSIPPI
 BOARD OF WATER COMMISSIONERS
 416 North State Street
 Jackson, Mississippi 39201

CODED

WATER WELL DRILLERS LOG

9-22 1979 Bradon Rumband Harrison
 date well completed firm name county well located
Well Serv. Inc

LANDOWNER: Steve McHair
Rt. 2, Box 64
Saucier, MS
 (mailing address)

description of formations encountered	from	to
Clay	0	20
Sand	20	60
Blue clay	60	220
Sand	220	280
Clay	280	340
Sand	340	440

WELL LOCATION:
 sec 22 T 5 R 11 E
2 1/2 miles S of Saucier
 (distance) (direction) (nearest town)

WELL PURPOSE: Home
 (home, irrigation, municipal, industrial)

CODED

- WELL COMPLETION DATA:
- (1) diameter (inches) 2"
 - (2) total depth (feet) 440'
 - (3) static water level (feet) 55' below top of ground.
 - (4) casing PVC, total,
 (material) (depth)
2" if telescope see back.
 (size)
 - (5) screen 10 ft, 430'
 (length) (depth to top)
2", 008 PVC underbar
 (size) (material)
 - (6) pump 1/2 HP, 10
 (HP) (yield gpm)
230
 (type power)
 - (7) electric log NO
 (yes or no)
- (organization running log)

(8) how well bottom plugged
2" sand shank

DRILLERS REMARKS:
no tailpipe

DEPT. OF NATURAL RESOURCES
 BUREAU OF LAND & WATER RESOURCES

DEC 21 1979


RECEIVED

If well telescopes please sketch and show depths.

GROUND LEVEL

08 02
08 02
Handwritten notes in the left column, including "08 02" repeated several times.

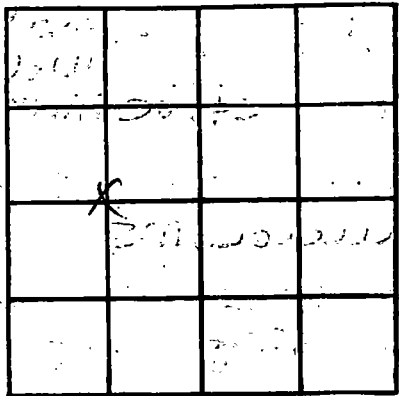

SECTION 20

Please indicate well location X.

ADDITIONAL INFORMATION

Handwritten notes in the 'ADDITIONAL INFORMATION' section, including "DIAP", "1-1-20", "0-1-17-21", and "1-1-17-21".

If more than one screen, show locations of each on sketch.