

Harrison
 C 188
 5-13-80

MISSISSIPPI
 BOARD OF WATER COMMISSIONERS
 416 North State Street
 Jackson, Mississippi 39201

CODE

WATER WELL DRILLERS LOG

4-21-80 date well completed
 Braden Pumpwell firm name
 Service, Inc
 Harrison county well located

LANDOWNER: WARD SMITH
 200 FORE ST.
 Gulfport, MS
 (mailing address)

description of formations encountered	from	to
CLAY SAND	0	162
	162	160

WELL LOCATION:
 sec 44 T 5 S R 11 E W
 1 1/2 miles S of Smiss
 (distance) (direction) (nearest town)

CODED

WELL PURPOSE: Home
 (home, irrigation, municipal, industrial)

- WELL COMPLETION DATA:
- (1) diameter (inches) 2"
 - (2) total depth (feet) 160'
 - (3) static water level (feet) 50 below top of ground
 - (4) casing PVC total!
 (material) (depth)
 2" (size) if telescope see back.
 - (5) screen 10' 150'
 (length) (depth to top)
 2" (size) PVC endcap (material)
 - (6) pump 1 8
 (HP) (yield gpm)
 230 (type power)
 - (7) electric log NO
 (yes or no)
 (organization running log)
 - (8) how well bottom plugged 2 sand shark

DEPT. OF NATURAL RESOURCES
 BUREAU OF LAND & WATER RESOURCES


MAY 7 - 1980

RECEIVED

DRILLERS REMARKS:
 No tail pipe

If well telescopes please sketch and show depths.

GROUND LEVEL

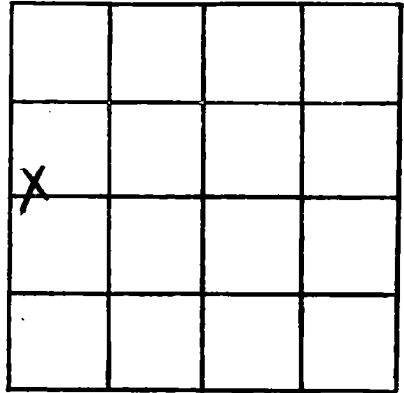

SECTION 24

Please indicate well location X.

ADDITIONAL INFORMATION

If more than one screen, show locations of each on sketch.