

HARRISON  
C 192  
4-14-80  
April 14

MISSISSIPPI  
BOARD OF WATER COMMISSIONERS  
416 North State Street  
Jackson, Mississippi 39201

CODED

WATER WELL DRILLERS LOG

date well completed

firm name

county well located

1980 *Sumner Well Drilling Harrison*

LANDOWNER

*William Perkins*

Description of formations encountered

from

to

*Rt. 1  
Lancier, Mo.*  
(mailing address)

*Clay 0 105  
Blue Clay 105 260  
Fine Sand 260 295  
Coarse Sand 295 315*

WELL LOCATION:

sec. *18* T *5* N R *11* E  
*3* miles *SE* of *Lancier*  
(distance) (direction) (nearest town)

WELL PURPOSE:

(home, irrigation, municipal, industrial)

*Home*

WELL COMPLETION DATA:

CODED

- (1) diameter (inches) *2"*
- (2) total depth (feet) *315 ft.*
- (3) static water level (feet) *70'*  Below  Above top of ground.
- (4) casing *PVC*, *305'*  
(material) (depth)
- (size) if telescope see back.
- (5) screen *10' 305'*  
(length) (depth to top)
- 2"*, *PVC*  
(size) (material)
- (6) pump *1*, *8*  
(HP) (yield gpm)
- electric*  
(type power)
- (7) electric log   
(yes or no)

(organization running log)

(8) how well bottom plugged

*Sand*  
*Mark*

DEPT. OF NATURAL RESOURCES  
BUREAU OF LAND & WATER RESOURCES


MAY 16 1980

DRILLERS REMARKS:

RECEIVED

If well telescopes please sketch and show depths.

GROUND LEVEL

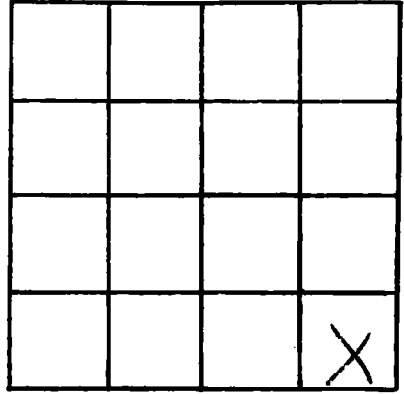

SECTION 18

Please indicate well location X.

ADDITIONAL INFORMATION

If more than one screen,  
show locations of each on sketch.