

MISSISSIPPI DEPARTMENT OF NATURAL RESOURCES

Bureau of Land and Water Resources

Southport Mall

P.O. Box 10631

Jackson, Mississippi 39209

WATER WELL DRILLERS LOG

CODED

HARRISON  
C 201

11/7/80  
11/7/80  
date well completed

19 Lyman Well Co  
firm name

Harrison  
county well located

LANDOWNER: Robert Thoust

description of formations encountered

from

to

Rt 2 Box 102

Saucier, Ms  
(mailing address)

yellow clay	0	12
light sand & gravel	12	63

WELL LOCATION:

sec. 25 T 5 N R 11 E  
16 miles NW of Biloxi  
(distance) (direction) (nearest town)

WELL PURPOSE: home  
(home, irrigation, municipal, industrial)

WELL COMPLETION DATA:

- (1) diameter (inches) 2"
- (2) total depth (feet) 63'
- (3) static water level (feet) 23' below top of ground
- (4) casing PVC 53' (material) (depth)  
2" (size) if telescope see back.
- (5) screen 10' 53' (length) (depth to top)  
2" (size) PVC (material)
- (6) pump (HP) (yield gpm)  
electric (type power)
- (7) electric log (yes or no)

CODED

(organization running log)

(8) how well bottom plugged sand shark

DRILLERS REMARKS:


DEPT. OF NATURAL RESOURCES  
BUREAU OF LAND & WATER RESOURCES

FEB 19 1981

RECEIVED

If well telescopes please sketch and show depths.

GROUND LEVEL

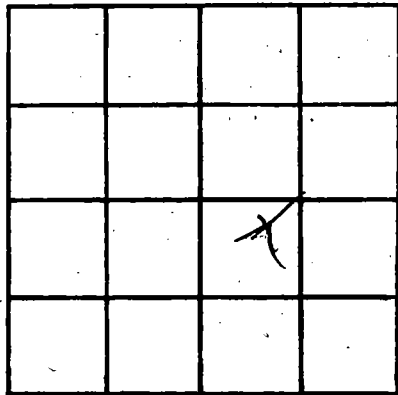

SECTION 23

Please indicate well location X.

ADDITIONAL INFORMATION

If more than one screen, show locations of each on sketch.