

MISSISSIPPI DEPARTMENT OF NATURAL RESOURCES

Bureau of Land and Water Resources

Southport Mall

P.O. Box 10631

Jackson, Mississippi 39209

WATER WELL DRILLERS LOG

CODED

HARRISON  
C 203  
2/12/81  
2/14/81

date well completed

firm name

county well located

Lyman Well Co.

Harrison

LANDOWNER:

John Weaver  
Rt 2 Box 156

description of formations encountered

from

to

Red & yellow glau sand & gravel 0 16  
16 50

Saucier, Md 39574  
(mailing address)

WELL LOCATION:

sec 2 T 5 N R 11 E  
16 miles W of Biloxi  
(distance) (direction) (nearest town)

CODED

WELL PURPOSE:

(home, irrigation, municipal, industrial)

WELL COMPLETION DATA:

- (1) diameter (inches) 4 1/2
- (2) total depth (feet) 50'
- (3) static water level (feet) 11' below top of ground
- (4) casing PVC 50' (material) (depth)
- (size) if telescope see back.
- (5) screen 18' 40' (length) (depth to top)
- 18' PVC (size) (material)
- (6) pump 1 (HP) 25 (yield gpm)
- 1/2 AC (type power)
- (7) electric log NO (yes or no)

(organization running log)

(8) how well bottom plugged S. April

DEPT. OF NATURAL RESOURCES  
BUREAU OF LAND & WATER RESOURCES


FEB 19 1981

RECEIVED

DRILLERS REMARKS:

If well telescopes please sketch and show depths.

GROUND LEVEL

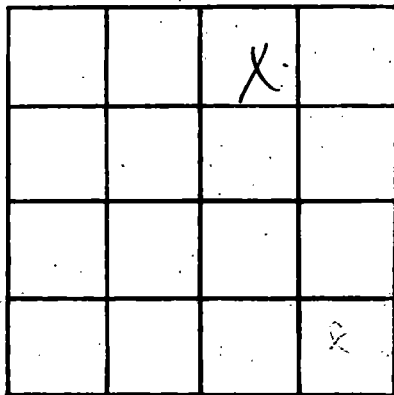

SECTION 2

Please indicate well location X.

ADDITIONAL INFORMATION

If more than one screen, show locations of each on sketch.