

MISSISSIPPI DEPARTMENT OF NATURAL RESOURCES

Bureau of Land and Water Resources

Southport Mall

P.O. Box 10631

Jackson, Mississippi 39209

WATER WELL DRILLERS LOG

CODED

HARRISON
C 203
3/16/81

Bill
0384

19 J-B WELL CO HARRISON

date well completed
MAR - 16 81

firm name

county well located

LANDOWNER: FARM

description of formations encountered

from to

BUREAU, Hy 49

0 - 8' Top So. 2
8 - 10 PINE STUMP
10 - 20 SAND WITH
30 99 SAND-CLAY
Bottom

GULE PART MS (mailing address)

WELL LOCATION:

sec. 3 T 5 N R 11 E
miles South of miles of miles
(distance) (direction) (nearest town)

WELL PURPOSE: COMMUNE & LAVATORY USE ONLY
(home, irrigation, municipal, industrial)

FOR COMMUNE
LAVATORY
AND LAWN
USE

WELL COMPLETION DATA:

- (1) diameter (inches) 2"
- (2) total depth (feet) 27'
- (3) static water level (feet) 8' below top of ground
- (4) casing (material) 2" 17' (depth)
- (size) if telescope see back.
- (5) screen 10' 17' (length) (depth to top)
- 2" PLASTIC (size) (material)
- (6) pump 1/2 HP 6 (yield gpm)
- (type power) Elec
- (7) electric log no (yes or no)

ONLY

CODED

DEPT. OF NATURAL RESOURCES
BUREAU OF LAND & WATER RESOURCES

JUN 2 - 1981

RECEIVED

(organization running log)


(8) how well bottom plugged PLASTIC CAP

DRILLERS REMARKS:

If well telescopes please sketch and show depths.

GROUND LEVEL

Handwritten notes:
S
ch
g
K

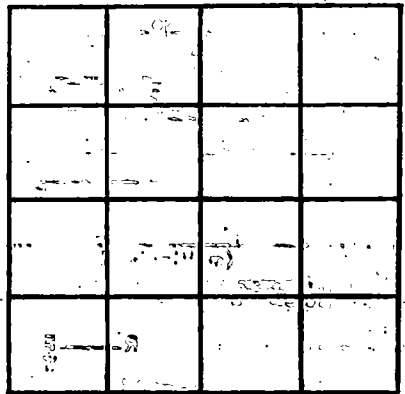

SECTION _____

Please indicate well location 'X'.

ADDITIONAL INFORMATION

If more than one screen, show locations of each on sketch.