

MISSISSIPPI DEPARTMENT OF NATURAL RESOURCES

Bureau of Land and Water Resources

Southport Mall

P.O. Box 10631

Jackson, Mississippi 39209

WATER WELL DRILLERS LOG

CODED

HARRISON
C 205
4/10/81
4/10/81

date/well completed

19

firm name

county well located

Lyman Well Co.

Harrison

LANDOWNER:

Mrs Carnado

description of formations encountered

from

to

Rt 2 Box 37 A

Jaucier 39574
(mailing address)

Red yellow Clay	0	26
Red yellow sand	26	50
Blue Clay	50	180
Sand	180	236

WELL LOCATION:

sec. 17 T. 5 N. R. 1 E.
3 miles SE of Saxon
(distance) (direction) (nearest town)

CODED

WELL PURPOSE:

(home, irrigation, municipal, industrial)

Home

WELL COMPLETION DATA:

- (1) diameter (inches) 4x2
- (2) total depth (feet) 236'
- (3) static water level (feet) 60' below top of ground
- (4) casing PVC, 216' (material) (depth)
- 4x2 (size) if telescope see back.
- (5) screen 20', 216' (length) (depth to top)
- 2" PVC (size) (material)
- (6) pump 1 (HP), 25' (yield gpm)
- electric (type power)
- (7) electric log NO (yes or no)
- NO (organization running log)
- (8) how well bottom plugged sand shark



DEPT. OF NATURAL RESOURCES
BUREAU OF LAND & WATER RESOURCES

MAY 20 1981

RECEIVED

DRILLERS REMARKS:

If well telescopes please sketch and show depths.


GROUND LEVEL



200'
4" PVC

16'
2" PVC

20'
2" screen

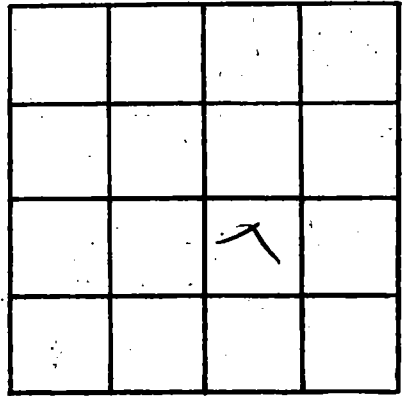

SECTION _____

Please indicate well location X.

ADDITIONAL INFORMATION

A series of horizontal lines for writing additional information, starting below the 'ADDITIONAL INFORMATION' header and extending to the bottom of the page.

If more than one screen, show locations of each on sketch.