

MISSISSIPPI DEPARTMENT OF NATURAL RESOURCES

Bureau of Land and Water Resources

Southport Mall

P.O. Box 10631

Jackson, Mississippi 39209

WATER WELL DRILLERS LOG

CODED

Harrison
C209
L-1-81

date well completed 19 JUN 21 firm name J B Well Co Harrison county well located _____

LANDOWNER: LINDA SCARR ROUGH
Rt Box 262 SAUCIER LA
(mailing address)

description of formations encountered	from	to
TOP SOIL	0	10
TOP SOIL CLAY SAND	10	20
SAND	20	30
SAND Coarse	30	40
PEA CRACK L	40	48

WELL LOCATION:
sec. 35 T. 45 N. R. 11 E. W. 5
miles 1 1/2 EAST of SAUCIER
(distance) (direction) (nearest town)

WELL PURPOSE: Home
(home, irrigation, municipal, industrial)

WELL COMPLETION DATA:

(1) diameter (inches) 2

(2) total depth (feet) 48

(3) static water level (feet) 12 below top of ground. above

(4) casing 2 38
(material) (depth)

(size) if telescope see back.

(5) screen 10 38
(length) (depth to top)

2 PLASTIC
(size) (material)

(6) pump 1 6 1/2
(HP) (yield gpm)

ELCC 8 9 2 L P.M
(type power) with 7 12

(7) electric log yes or no

(organization running log) PLAS

(8) how well bottom plugged Plug

CODED

DEPT. OF NATURAL RESOURCES
BUREAU OF LAND & WATER RESOURCES


JUN 20 1981

RECEIVED

DRILLERS REMARKS:

If well telescopes please sketch and show depths.

GROUND LEVEL

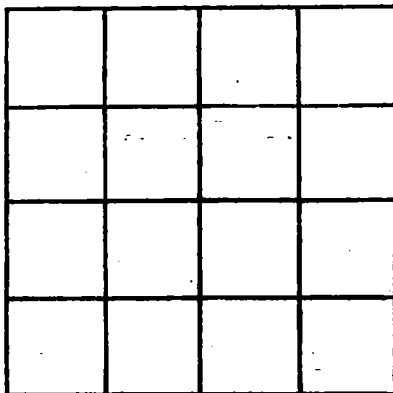

SECTION _____

Please indicate well location X.

ADDITIONAL INFORMATION

If more than one screen, show locations of each on sketch.