

MISSISSIPPI DEPARTMENT OF NATURAL RESOURCES

Bureau of Land and Water Resources

Southport Mall

P.O. Box 10631

Jackson, Mississippi 39209 CODED

WATER WELL DRILLERS LOG

COASTAL DRILLING & SERVICE CO.

HARRISON
C 213
7/30/81

7/30
date well completed

1981 ROUTE 1 BOX 618
WELL NUMBER

Harrison
county well located

BILOXI, MISS 39532

LANDOWNER: *L. O. Neal*
lt 2
Sarasin Series
(mailing address)

description of formations encountered	from	to
<i>top soil</i>	1	3
<i>Red Clay</i>	3	15
<i>Orange Sand</i>	15	23
<i>Blueish Sand</i>	23	62


WELL LOCATION:
sec. 2 T. 5 N. R. 11 E.
(2 1/2 miles North Sarasin)
(distance) (direction) (nearest town)

Rest in Water

WELL PURPOSE: *home*
(home, irrigation, municipal, industrial)

- WELL COMPLETION DATA:
- (1) diameter (inches) 2"
 - (2) total depth (feet) 62'
 - (3) static water level (feet) 15' below above top of ground.
 - (4) casing PVC, 52',
(material) (depth)
(size) if telescope see back.
 - (5) screen 10', 52'
(length) (depth to top)
2", PVC
(size) (material)
 - (6) pump One 1/2, 12
(HP) (yield gpm)
Ele
(type power)
 - (7) electric log no
(yes or no)
- (organization running log)

CODED

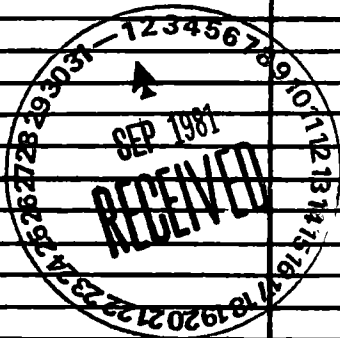

(8) has well bottom plugged
2' head water volume
DRILLERS REMARKS: 09-B

