

MISSISSIPPI DEPARTMENT OF NATURAL RESOURCES

Bureau of Land and Water Resources

Southport Mall

P.O. Box 10631

Jackson, Mississippi 39209

WATER WELL DRILLERS LOG

CODED

HARRISON  
C 214  
5-18-81

May 18 1981

Duncan Well Drilling Harrison

date well completed

firm name

county well located

LANDOWNER:	Description of formations encountered	from	to
<u>Martha Edwards, Jr</u> <u>Rt. 2 Box 119B</u> <u>Saucier, Mo. 39574</u> (mailing address)	<u>Clay</u> <u>Sand</u>	<u>0</u>	<u>16</u> <u>80</u>

WELL LOCATION:  
sec. 33 T 5 N R 11 E  
6 miles S.E. of Saucier  
(distance) (direction) (nearest town)

WELL PURPOSE: Home  
(home, irrigation, municipal, industrial)

WELL COMPLETION DATA:

(1) diameter (inches) 2"

(2) total depth (feet) 80 ft.

(3) static water level (feet) 35' below top of ground above

(4) casing PVC 80'  
(material) (depth)

(size) If telescope see back.

(5) screen 10' 70'  
(length) (depth to top)

(size) 2" PVC  
(material)

(6) pump 1/2 8  
(HP) (yield gpm)

electric  
(type power)

(7) electric log             
(yes or no)

(organization running log)

(8) how well bottom plugged hard  
start

CODED


DEPT. OF NATURAL RESOURCES  
BUREAU OF LAND & WATER RESOURCES

OCT 19 1981  
RECEIVED

DRILLERS REMARKS:

If well telescopes please sketch and show depths.

GROUND LEVEL

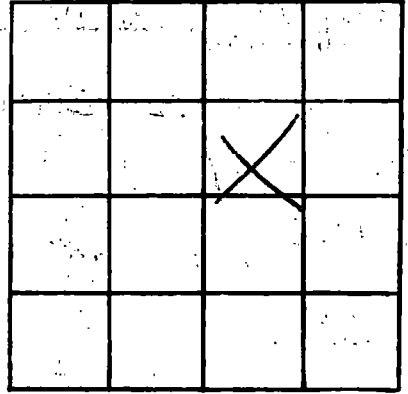

SECTION 33

Please indicate well location X.

ADDITIONAL INFORMATION

If more than one screen, show locations of each on sketch.