

MISSISSIPPI DEPARTMENT OF NATURAL RESOURCES

Bureau of Land and Water Resources

Southport Mall

P.O. Box 10631

Jackson, Mississippi 39209

WATER WELL DRILLERS LOG

CODED

HARRISON
C 215
6-11-81

June 11 1981 Monroe Well Drilling Harrison
date well completed firm name county well located

LANDOWNER: B.O. Strickland
Rt. 2 Box 39-A
Saucier, Ms. 39574
(mailing address)

description of formations encountered	from	to
clay	0	17
sand	17	35
white clay	35	80
blue clay	80	275
fine sand	275	290
coarse sand	290	310

WELL LOCATION:
sec 20 T 5 N R 11 E
3 miles SE of Saucier
(distance) (direction) (nearest town)

WELL PURPOSE: Home
(home, irrigation, municipal, industrial)

WELL COMPLETION DATA:

(1) diameter (inches) 2" X 4" 160 4.4"
150 4.2"

(2) total depth (feet) 310 ft

(3) static water level (feet) 65 ft below above top of ground.

(4) casing PVC, 300'
(material) (depth)

(size) if telescope see back.

(5) screen 10', 300'
(length) (depth to top)

(size) PVC
(material)

(6) pump 1/2, 20
(HP) (yield gpm)

electric
(type power)

(7) electric log
(yes or no)

(organization running log)

(8) how well bottom plugged Sand


CODED

DRILLERS REMARKS: Mark

DEPT. OF NATURAL RESOURCES
BUREAU OF LAND & WATER RESOURCES
OCT 19 1981
RECEIVED

If well telescopes please sketch and show depths.

GROUND LEVEL

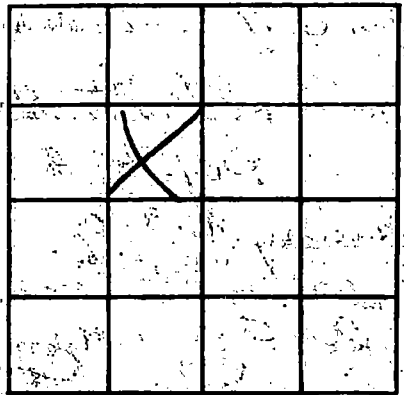

SECTION 20

Please indicate well location X.

ADDITIONAL INFORMATION

If more than one screen, show locations of each on sketch.