

MISSISSIPPI DEPARTMENT OF NATURAL RESOURCES

Bureau of Land and Water Resources

Southport Mall

P.O. Box 10631

Jackson, Mississippi 39209

WATER WELL DRILLERS LOG

CODED

HARRISON  
C 217  
5-15-81

5-15-81  
date well completed

19 Lyman Well Co.  
firm name

Harrison  
county well located

LANDOWNER: Varnado  
Rt 2 Box 82R3  
Saucier, Md 39574  
(mailing address)

description of formations encountered	from	to
	<u>Red &amp; yellow clay</u>	<u>0</u>
<u>Red Sand</u>	<u>16</u>	<u>20</u>

WELL LOCATION:  
sec. 28 T. 5 N. R. 11 E.  
3 miles SE of Saucier  
(distance) (direction) (nearest town)

WELL PURPOSE: home  
(home, irrigation, municipal, industrial)

- WELL COMPLETION DATA:
- (1) diameter (inches) 2"
  - (2) total depth (feet) 30'
  - (3) static water level (feet) 50 below above top of ground.
  - (4) casing PVC 40'  
(material) (depth)  
2"  
(size) if telescope see back.
  - (5) screen 10' 70'  
(length) (depth to top)  
2" PVC  
(size) (material)
  - (6) pump 1 7  
(HP) (yield gpm)  
electric  
(type power)
  - (7) electric log No  
(yes or no)  
NO  
(organization running log)
  - (8) how well bottom plugged sand  
shark

CODED

DEPT. OF NATURAL RESOURCES  
BUREAU OF LAND & WATER RESOURCES


OCT 20 1981

RECEIVED

DRILLERS REMARKS:

If well telescopes please sketch and show depths.

GROUND LEVEL

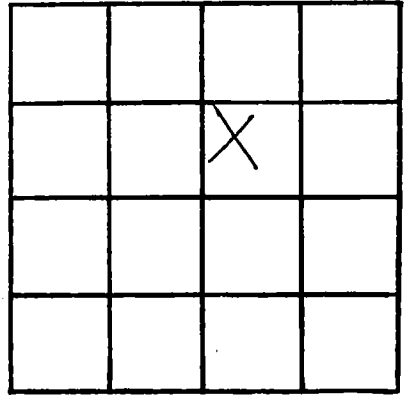

SECTION 28

Please indicate well location X.

ADDITIONAL INFORMATION

If more than one screen,  
show locations of each on sketch.