

MISSISSIPPI DEPARTMENT OF NATURAL RESOURCES

Bureau of Land and Water Resources

Southport Mall

P.O. Box 10631

Jackson, Mississippi 39209

WATER WELL DRILLERS LOG

HARRISON  
C 218  
7-3-81

CODED

7/31/81 19 Lymann Well Co. Harrison  
date well completed firm name county well located

This is about 1/2 mi SE of

LANDOWNER: Elizabeth Brooker  
Wortham Rd

Saucier 39574 (mailing address)  
yellow clay 0 7  
red & purple clay 7 21  
yellow sand & gravel 21 90

WELL LOCATION:  
sec. 32 5 N R 11 E  
24 miles SE of Saucier  
(distance) (direction) (nearest town)

WELL PURPOSE: none  
(home, irrigation, municipal, industrial)

WELL COMPLETION DATA:

(1) diameter (Inches) 2"

(2) total depth (feet) 90'

(3) static water level (feet) 30' below top of ground

(4) casing PVC  
(material) (depth)

2"  
(size) If telescope see back.

(5) screen 10'  
(length) (depth to top)

2" PVC  
(size) (material)

(6) pump 1 12  
(HP) (yield gpm)

electric  
(type power)

(7) electric log NO  
(yes or no)

NO  
(organization running log)

(8) how well bottom plugged sand shark

DRILLERS REMARKS:

CODED


DEPT. OF NATURAL RESOURCES  
BUREAU OF LAND & WATER RESOURCES

OCT 20 1981

RECEIVED

If well telescopes please sketch and show depths.

GROUND LEVEL

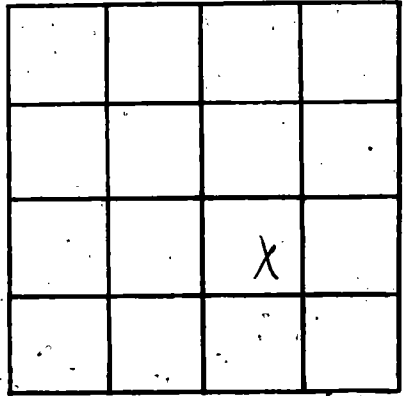

SECTION 32

Please indicate well location X.

ADDITIONAL INFORMATION

If more than one screen, show locations of each on sketch.