

MISSISSIPPI DEPARTMENT OF NATURAL RESOURCES

Bureau of Land and Water Resources

Southport Mall

P.O. Box 10631

Jackson, Mississippi 39209

WATER WELL DRILLERS LOG

HARRISON
C-219
9-10-81

CODED

9/10/81
date well completed

Syman Well Co.
firm name

Harrison
county well located

LANDOWNER: Church of Christ
P.O. Box 248
Saucier, Ms 39574
(mailing address)

description of formations encountered	from	to
Red Clay	0	15
fine Red Sand	15	60
gray Clay some	60	140
fine Sand		
Blue Clay	140	194
gray sand & salt	194	237
a pebbles Sand		

WELL LOCATION:
sec. 6 T 5 N R 11 E
in miles Saucier of
(distance) (direction) (nearest town)

WELL PURPOSE: home
(home, irrigation, municipal, industrial)

WELL COMPLETION DATA:

(1) diameter (inches) 2"

(2) total depth (feet) 237'

(3) static water level (feet) 80 Below top of ground.

(4) casing PVC 227' (material) (depth)
2" (size) If telescope see back.

(5) screen 10' 227' (length) (depth to top)
2" (size) PVC (material)

(6) pump 1 (HP) 12 (yield gpm)
electric (type power)

(7) electric log NO (yes or no)
NO (organization running log)

CODED

(8) how well bottom plugged sand seal

DRILLERS REMARKS:


DEPT. OF NATURAL RESOURCES
BUREAU OF LAND & WATER RESOURCES

OCT 20 1981

RECEIVED

If well telescopes please sketch and show depths.

GROUND LEVEL

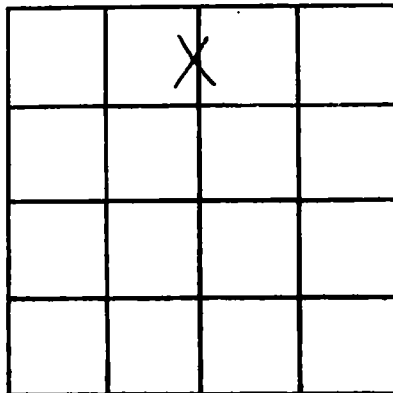

SECTION 6

Please indicate well location X.

ADDITIONAL INFORMATION

If more than one screen, show locations of each on sketch.