

MISSISSIPPI DEPARTMENT OF NATURAL RESOURCES

Bureau of Land and Water Resources

Southport Mall

P.O. Box 10631

Jackson, Mississippi 39209

WATER WELL DRILLERS LOG

HARRISON
C 220
9-10-81

CODED

9/10/81 date well completed
Lyman Well Co. firm name
Harrison county well located

LANDOWNER: Michael Gartman

Description of formations encountered	from to	
Red clay	0	12
Red - yellow purple	12	27
yellow clay	27	31
sand & gravel	31	94

RT 2, Box 125
Laurie Thd 39574
(mailing address)

WELL LOCATION:
sec. 26 5 N R. 11 E S. 10 miles W/E of Lyman (distance) (direction) (nearest town)

WELL PURPOSE: Home
(home, irrigation, municipal, industrial)

- WELL COMPLETION DATA:
- (1) diameter (inches) 2"
 - (2) total depth (feet) 94
 - (3) static water level (feet) 32 Below top of ground.
 - (4) casing PVC, 84' (material) (depth)
2" (size) if telescope see back.
 - (5) screen 10' length, 84' depth to top
2" (size) PVC (material)
 - (6) pump 1 1/2 HP, 12 yield gpm
Electric (type power)
 - (7) electric log No (yes or no)
(organization running log)
 - (8) how well bottom plugged Sand Shark

CODED


DEPT. OF NATURAL RESOURCES
BUREAU OF LAND & WATER RESOURCES

OCT 20 1981
RECEIVED

DRILLERS REMARKS:

If well telescopes please sketch and show depths.

GROUND LEVEL

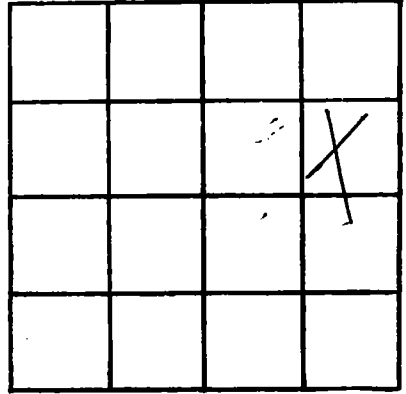

SECTION 26

Please indicate well location X.

ADDITIONAL INFORMATION

If more than one screen, show locations of each on sketch.