

MISSISSIPPI DEPARTMENT OF NATURAL RESOURCES

Bureau of Land and Water Resources

Southport Mall

P.O. Box 10631

Jackson, Mississippi 39209

WATER WELL DRILLERS LOG

Harrison
C 222

CODED

11/2/81
date well completed

Lipman Well
firm name

Harrison
county well located

LANDOWNER Raymond Smalley
Tuxon Road Suwanee
(mailing address)

Description of formations encountered	from	to
<u>white sand</u>	<u>0</u>	<u>80</u>
<u>Red sand gravel</u>		
<u>Red Clay</u>		
<u>Clay</u>	<u>80</u>	<u>180</u>
<u>fine sand</u>	<u>180</u>	<u>215</u>
<u>Fine sand</u>	<u>215</u>	<u>260</u>
<u>Blue clay</u>	<u>260</u>	<u>344</u>
<u>Good sand & gravel</u>	<u>344</u>	<u>402</u>

WELL LOCATION:
sec. 29 T S N. R. 11 E W
3 miles SE of Sauvies
(distance) (direction) (nearest town)

WELL PURPOSE: Home
(home, irrigation, municipal, industrial)

- WELL COMPLETION DATA:
- (1) diameter (inches) 2"
 - (2) total depth (feet) 402'
 - (3) static water level (feet) 85 ^{below} _{above} top of ground.
 - (4) casing PVC 392'
(material) (depth)
2" if telescope see back.
(size)
 - (5) screen 10' 392"
(length) (depth to top)
2" PVC
(size) (material)
 - (6) pump 1 8
(HP) (yield gpm)
electric
(type power)
 - (7) electric log NO
(yes or no)
NO
(organization running log)
 - (8) how well bottom plugged sand shark


CODED

APR 23 1982

DRILLERS REMARKS:

If well telescopes please sketch and show depths.

GROUND LEVEL

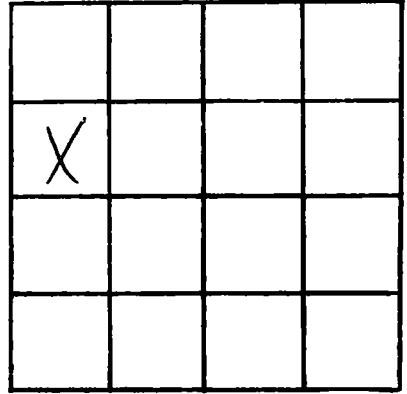

SECTION 29

Please indicate well location X.

ADDITIONAL INFORMATION

If more than one screen, show locations of each on sketch.